

Name Telfer Const. Co.

Service No. 3290

Address 144 Simonds Road

#5124

Lexington, Mass.

Location 144 Simonds Road

Kind of Pipe

Size

Size of Main

~~Repair/Rebuild~~ - New Service

Location

Date	Material	Amount	Total	Date	Location	Amount
June 26, '47	Labor	20 10	20 10	June 20 '47	Deposited	50 00
	10% Overhead		2 01	Sept 25 '47	Refunded	6 29
	36' - 3/4" Copper Tubing @.27		9 72		Non-Charge	43 73
	1 - 3/4" C x 1/2" I.W.H. S & W		3 15	June 26, '47	Labor	15 10
	Patching 8 x 3		8 00		16' - 3/4" Copper Tubing @.27	4 32
	Trucking 1 hr. @.75		75		1 - 3/4" C Corp-cock	3 00
			43 73		1 - 3/4" C x 3/4" C Curb-cock	3 68
					1 - Box & Rod	4 26
					1 - 1/2" Straight Tail Piece	30
					1 - 1/2" Offset Tail Piece	30
					Trucking 1 hr. @.75	75
	Labor					31 71

Hidley Press, Inc., Lexington

TOWN OF LEXINGTON—BOARD OF PUBLIC WORKS

WATER DIVISION

The undersigned applies for a supply of water at No. _____ St. and hereby agrees to comply with the rules and regulations as now, or at any future time, established by the Board of Selectmen.

Am't. of Estimate \$ _____


Owner _____

Am't. Paid \$ _____

Address _____

308 312 Salem Street
Madford Man

Builder _____

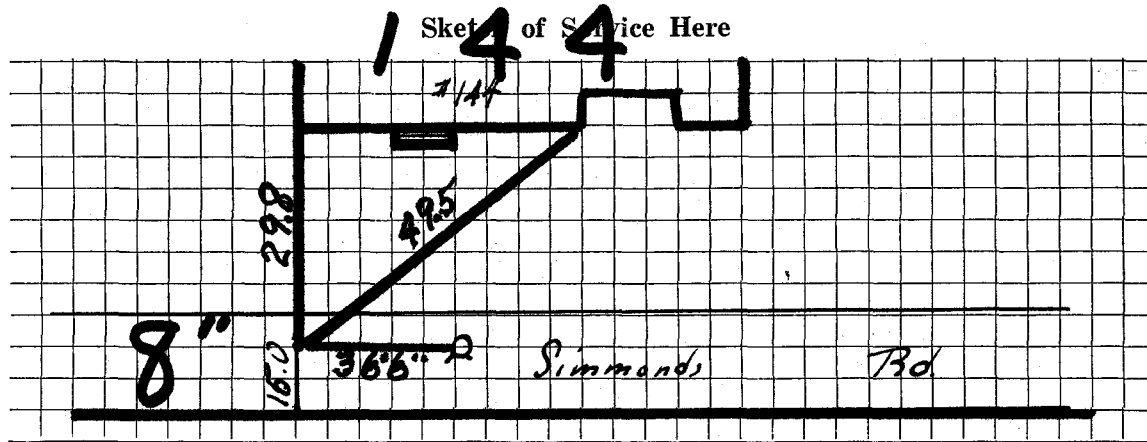

Connection made in _____ Street.

Work completed _____ 19

Remarks: