

Name J. Everett Ready

Service No. ~~26~~ 2485

Address ~~1782 Mass. Ave. Lexington~~

31 Simmonds Rd

Location

#31 Simmonds Rd.

Corner Gleason & Simonds Roads

#7775

Kind of Pipe

Size

Size of Main

Repair—Renewal—New Service

Location

Date  
1940

Material

Amount

Total

Date

Amount

June 27

9 hrs. @ 60¢

5 40

June 20, 1940 Deposited

39 00

from 9/9/40.

10% Overhead

54

5 94

September 13, 1940 Repaid

2 83

36' 3/4" Cop. tub. @ 18¢

6 48

1 3/4" C.x. 1/2" I.S. & W.

2 25

2 hrs. trucking @ 75¢

1 50

Trench Repairs

-20 00

36 17

36 17

Labor

34'  
\$ 17.00 Patching  
\$ 39.00

DATE June 20, 1940

# TOWN OF LEXINGTON—BOARD OF PUBLIC WORKS

## WATER DIVISION

The undersigned applies for a supply of water at No. Corner Mason & Simmonds St. and hereby agrees to comply with the rules and regulations as now, or at any future time, established by the Board of Selectmen.

Am't. of Estimate \$ 39.00

Owner

J. Everett Ready <sup>Per</sup> <sub>Hand</sub>


Am't. Paid \$ \_\_\_\_\_

Address

1782 Mass Ave  
Lexington

Builder \_\_\_\_\_

Sketch of Service Here

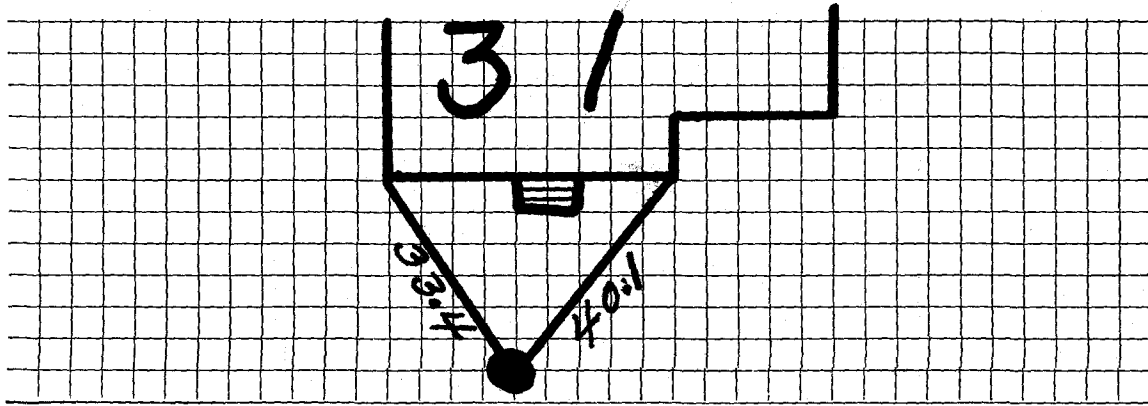

Connection made in \_\_\_\_\_ Street.

Work completed \_\_\_\_\_ 19

Remarks: