

Name Gunerius Nelsen

Service No. ~~78~~ 2486

Address ~~7 Newcomb Street, Arlington, Mass.~~

#1829

32 Simonds St

Location

32 Simonds Road.

Kind of Pipe

Size

Size of Main

Repair—Renewal—New Service

Location

Date

Material

Amount

Total

Date

Amount

Oct. 22, 1940

8 hrs. @ 60¢

4 80

from 12-31-40

10% Overhead

48

5 28

33' 3/4" Copper tubing @ 19¢

6 27

1 3/4" C.S.& W.

2 25

1 hr. trucking @ 75¢

75

Trench repairs

3 00

\$17 55

October 17, 1940 Deposited

19 00

Dec 31, 1940 Refund

14 00

17 00

Labor

Hadley Press, Inc., Lexington

DATE October 7, 1940

TOWN OF LEXINGTON—BOARD OF PUBLIC WORKS

WATER DIVISION

The undersigned applies for a supply of water at No. 32 Simmonds Rd St. and hereby agrees to comply with the rules and regulations as now, or at any future time, established by the Board of Selectmen.

Am't. of Estimate \$ 19.00

Owner Burneius Nelson


Am't. Paid \$ _____

Address 7 Newcomb st

Builder Nelson

Lexington

Sketch of Service Here

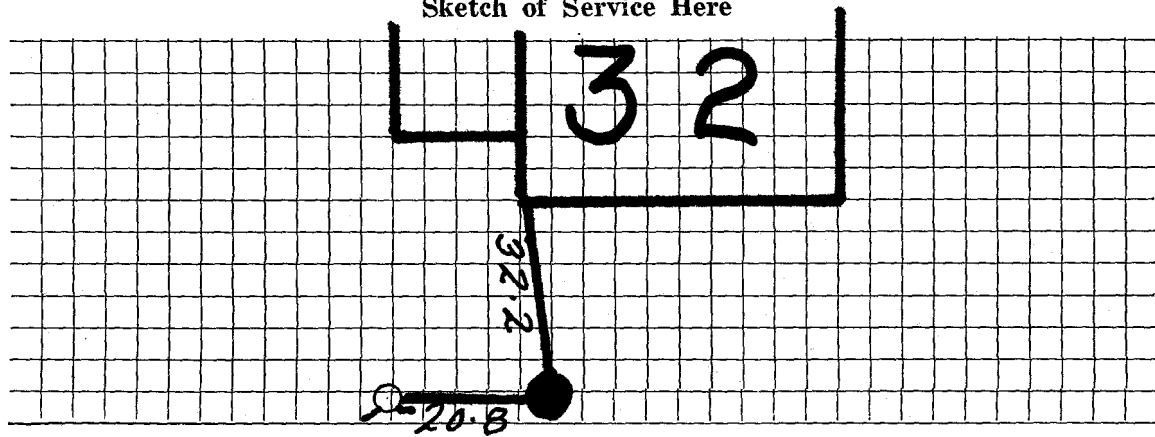

Connection made in _____ Street.

Work completed _____ 19

Remarks: