

Name

Service No. 2489

Address 53 Simonds

#. 853

Location

53 Simonds Road.

Kind of Pipe

Size

Size of Main

Repair—Renewal—New Service

Location

Date

Material

Amount

Total

Date

Amount

Repair Leak W.O. #256

3/5/79

Labor

2 1" Style 38

2 1" x 4" Nipple

1 3/4" Curb

6 yds. Gravel

4 tons 1" Stone

4 hr. Trucking

2 1/2 hrs. Town Shovel

Labor

TOWN OF LEXINGTON—BOARD OF PUBLIC WORKS

WATER DIVISION

The undersigned applies for a supply of water at No. _____ St. and hereby agrees to comply with the rules and regulations as now, or at any future time, established by the Board of Selectmen.

Am't. of Estimate \$ _____

Owner

Riefinger.


Am't. Paid \$ _____

Address

53. Simonds Rd.

Builder _____

Sketch of Service Here

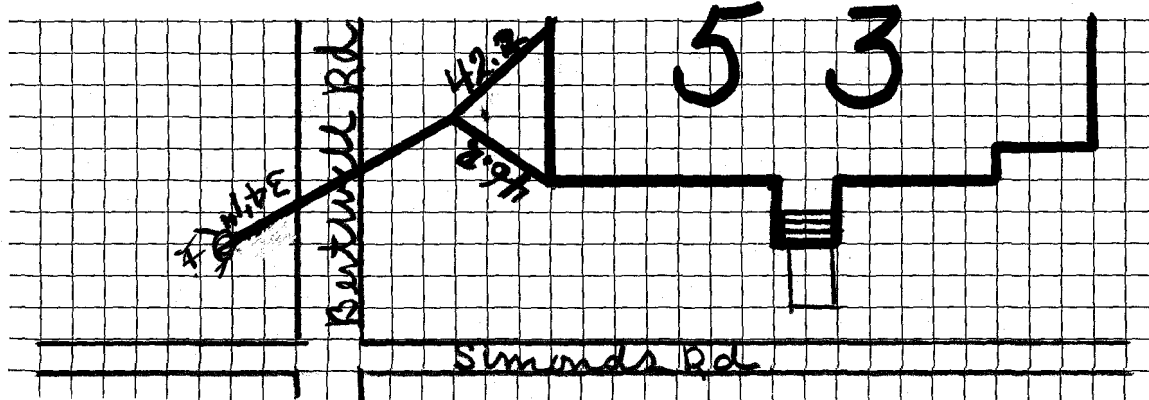

Connection made in _____ Street.

Work completed _____ 19

Remarks: