

Name

Service No. 2490

49

Address

54 Simonds Rd

Location

54 Simonds Road

Kind of Pipe

Size

Size of Main

Repair—Renewal—New Service

Location

Date

Material

Amount

Total

Date

Amount

Labor

DATE \_\_\_\_\_

# TOWN OF LEXINGTON—BOARD OF PUBLIC WORKS

## WATER DIVISION

The undersigned applies for a supply of water at No. \_\_\_\_\_ St. and hereby agrees to comply with the rules and regulations as now, or at any future time, established by the Board of Selectmen.

Am't. of Estimate \$ \_\_\_\_\_

Owner

R. Groerer.


Am't. Paid \$ \_\_\_\_\_

Address

54 Simonds Rd

Builder \_\_\_\_\_

Sketch of Service Here

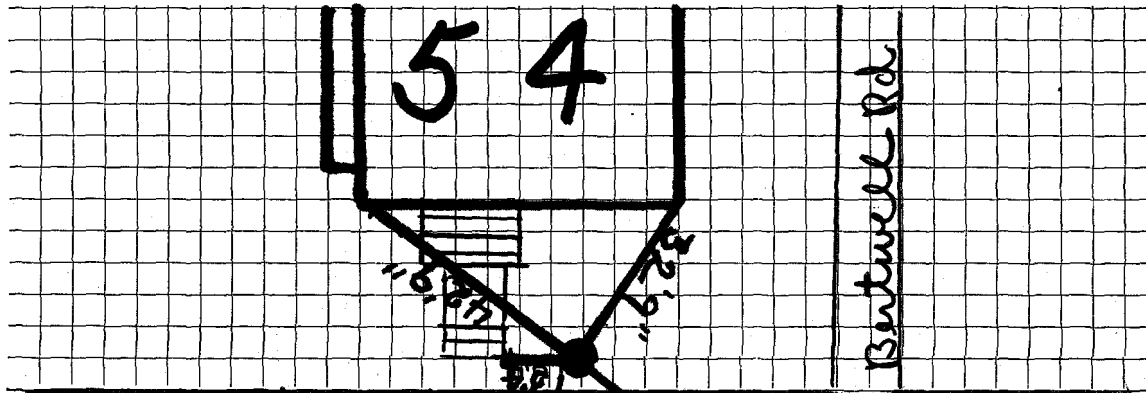

Connection made in \_\_\_\_\_

Simonds Rd.

Street.

Work completed \_\_\_\_\_

19

Remarks: