

Name H. E. Crocker

1084 100  
Service No. 3352

Address 61 Simonds Road

Location 61 Simonds Road

Kind of Pipe

Size

Size of Main

~~XXXXXXXXXX~~ New Service

Com 12-1-47

Location

| Date         | Material                       | Amount | Total | Date                          | Amount |
|--------------|--------------------------------|--------|-------|-------------------------------|--------|
| Sept. 3, '47 | Labor                          | 1 10   | 1 10  | Sept 2 '47                    | 20 00  |
|              | 10% Overhead                   |        | 11    | Dec 4 '47                     | 2 41   |
|              | 48' - 3/4" Copper Tubing @.26  | 12 48  |       |                               | 17 59  |
|              | 1 - 3/4" C x 1/2" I.W.H. S & W | 3 15   |       | Sept. 3, '47                  | 9 50   |
|              | Trucking 1 hr. @.75            |        | 75    | 12' - 3/4" Copper Tubing @.26 | 3 12   |
|              |                                |        | 17 59 | 1 - 3/4" C Corp-cock          | 3 00   |
|              |                                |        |       | 1 - 3/4" C x 3/4" C Curb-cock | 3 68   |
|              |                                |        |       | 1 - Box & Rod                 | 4 26   |
|              |                                |        |       | 1 - 1/2" Straight Tail Piece  | 30     |
|              |                                |        |       | 1 - 1/2" Offset Tail Piece    | 30     |
|              |                                |        |       | Trucking 1 hr. @.75           | 75     |
|              |                                |        |       |                               | 24 91  |
|              | Labor                          |        |       |                               |        |

Alfred Smart

DATE \_\_\_\_\_

TOWN OF LEXINGTON - BOARD OF PUBLIC WORKS

**WATER DIVISION**

The undersigned applies for a supply of water at No..... St. and hereby agrees to comply with the rules and regulations as now, or at any future time, established by the Board of Selectmen.

Am't of Estimate \$.....

Owner .....


Am't Paid \$.....

Address .....

Builder .....

261 Orchard St Newton Mass

Sketch of Service Here

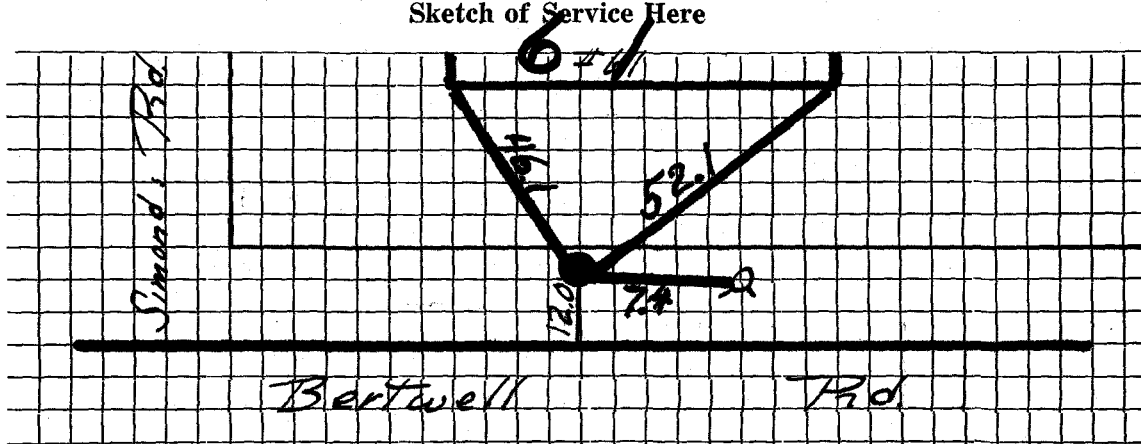

Connection made in ..... Street.

Work completed .....19

Remarks: