

WATER SERVICE RECORD

Name: Richard Dreselly

Service No. 238

Address 62 Simonds Road

Location Lexington, Mass.

1841
check mailed to: 1 Grassland St.
12-12-51

~~Repair~~ ~~Renewal~~ New Service

Com. 12-23-51


Date	Material	Amount	Total	Date	Amount
11/5/51	Labor	1 65	1 65	9-24-51 Deposited	25 00
	10% overhead		17	12-3-51 Refunded	(4 09)
	44' - 3/4" copper tubing @ .326-14	34	34		20 91
	1 - 3/4" C x 1/2 I.W.H. stop & waste	4 00	4 00		
	1 hr. trucking		75		
			20 91		
				11-5/51 labor	1 65
				13' - 3/4" copper tubing @ .326	4 23
				1 - 3/4" C. corp-cock	4 33
				1 - 3/4" C x 3/4" C. curb-cock	4 67
				1 box and rod	4 68
				1 - 1/2 offset tail piece	50
				1 - 1/2 straight tail piece	50
				1 hr. trucking	75
				11-25-74	21 31
				15" 3/4" Copper	
				2 3 Part Unions	

DATE _____

TOWN OF LEXINGTON — BOARD OF PUBLIC WORKS

WATER DIVISION

Sketch of Service Here

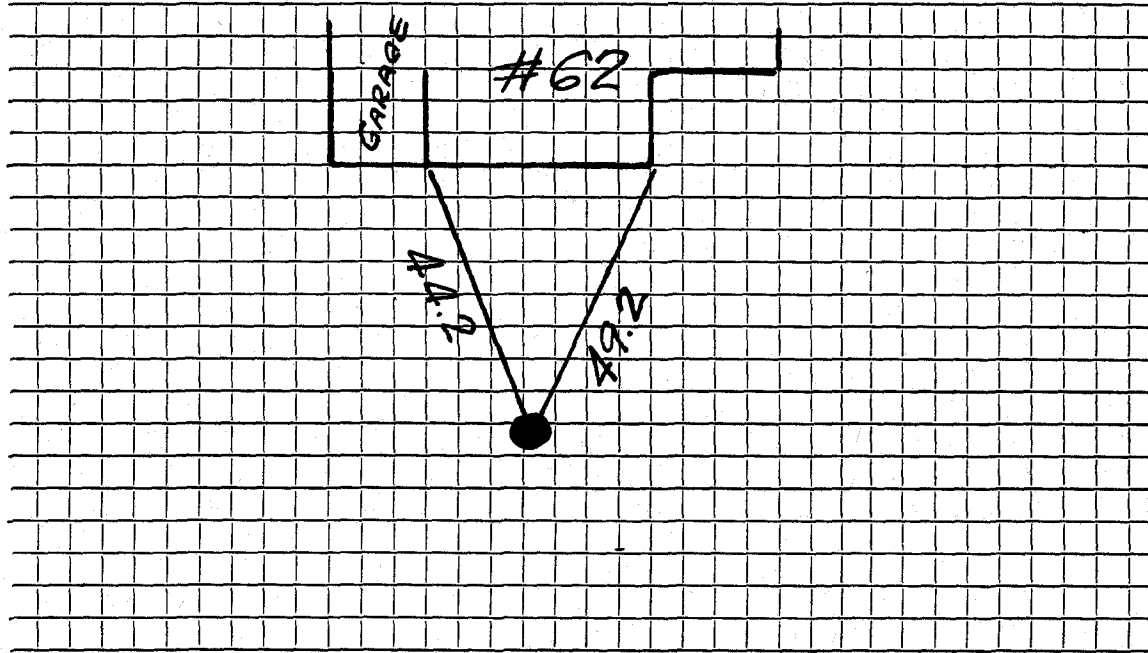

Connection made in Street. Work completed

Remarks:

.....

.....