

WATER SERVICE RECORD

2696

Name Thomas Webster

Service No. 244

Address 66 Simonds Road

Location

RANGE 10-5-53
~~Range 10-5-53~~—New Service


Date	Material	Amount	Total	Date	Amount
9/10/53	Labor	1 75		8-17-53	Deposited 25 00
	10% overhead	18	1 93	10-5-53	Refunded (1 99)
	45' - 3/4" copper tubing @ .3629		16 33		<u>NON CHARGE</u> 23 01
	1 - 3/4" C. x 1/2" I.W.H. stop & waste		4 00	9/10/53	Labor 1 75
	1 hr. trucking		75	20' - 3/4" copper tubing @ .3629	7 26
			23 01	1 - 3/4" C. corp-cock	4 33
				1 - 3/4" C x 3/4" C. curb-cock	4 67
				1 box and rod	3 90
				1 - 1/2" offset tail piece	50
				1 - 1/2" straight tail piece	50
				1 hr. trucking	75
					<u>23 66</u>

DATE _____

TOWN OF LEXINGTON — BOARD OF PUBLIC WORKS

WATER DIVISION

Sketch of Service Here

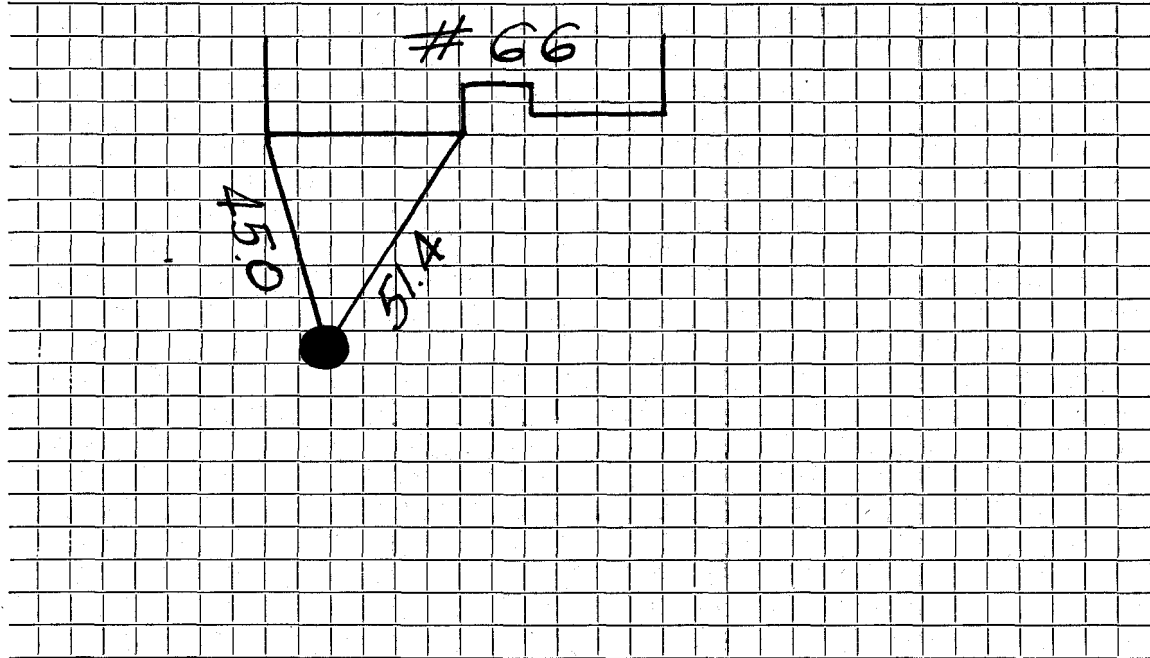

Connection made in Street. Work completed

Remarks:
.....
.....