

Name Glen Wright

Service No. 165

Address 67 Simonds Road

424

Lexington, Mass.

Location 67 Simonds Road

Kind of Pipe

Size

Size of Main

~~XXXXXXXXXXXX~~ New Service

Com. 9-26-49

Location

Date	Material	Amount	Total	Date	Amount
Sept. 6, '49	Labor	1 35	1 35	Aug 16 '49	15 00
	10% Overhead		14	Aug 16 '49	0 25
	26' - 3/4" Copper Tubing @ .24	6 24			No Charge
	1 - 3/4" C x 1/2" I.W.H. S&W	3 29		Sept. 6, '49	Labor
	Trucking 1 hr. @ .75	75			30' - 3/4" Copper Tubing @ .24
			11 77		1 - 3/4" C Corp-cock
					1 - 3/4" C x 3/4" C Curb-cock
					1 - Box & Rod
					1 - 1/2" Straight Tail Piece
					1 - 1/2" Offset Tail Piece -
					Trucking 1 hr. @ .75
					20 79
	Labor				

DATE _____

TOWN OF LEXINGTON - BOARD OF PUBLIC WORKS

WATER DIVISION

The undersigned applies for a supply of water at No..... St. and hereby agrees to comply with the rules and regulations as now, or at any future time, established by the Board of Selectmen.

Am't of Estimate \$.....

Owner


Am't Paid \$.....

Address

Builder

.....

Sketch of Service Here

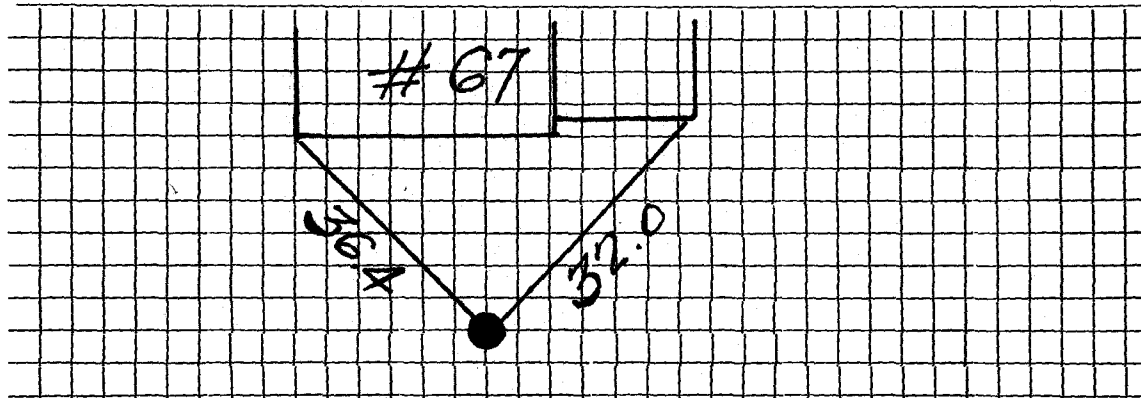

Connection made in Street.

Work completed19

Remarks: