

Name Clayton Pluff

Service No. 27

Address 70 Simonds Road

#1641

Lexington, Mass.

Location 70 Simonds Road

6926

Kind of Pipe

Size

Size of Main

~~WORK IN PROGRESS~~—New Service

Com. 5-2-49

Location

Date	Material	Amount	Total	Date	Amount
March 21, '49	Labor	2 15	2 15	March 21, '49	20 00
	10% Overhead		22	May 5, '49	4 14
	35' - 3/4" Copper Tubing @.27		9 45		15 86
	1 - 3/4" C x 1/2" I.W.H. S. & W.		3 29	March 21, '49	2 15
	Trucking 1 hr. @.75		75	11' - 3/4" Copper Tubing @.27	2 97
			15 86	1 - 3/4" C Corp-cock	3 15
				1 - 3/4" C x 3/4" C Curb-cock	3 85
				1 - Box & Rod	3 95
				1 - 1/2" Offset Tail Piece	37
				1 - 1/2" Straight tail piece	37
				Trucking 1 hr. @.27	75
					17 56
	Labor				

DATE _____

TOWN OF LEXINGTON - BOARD OF PUBLIC WORKS

WATER DIVISION

The undersigned applies for a supply of water at No..... St. and hereby agrees to comply with the rules and regulations as now, or at any future time, established by the Board of Selectmen.

Am't of Estimate \$.....

Owner


Am't Paid \$.....

Address

Builder

.....

Sketch of Service Here

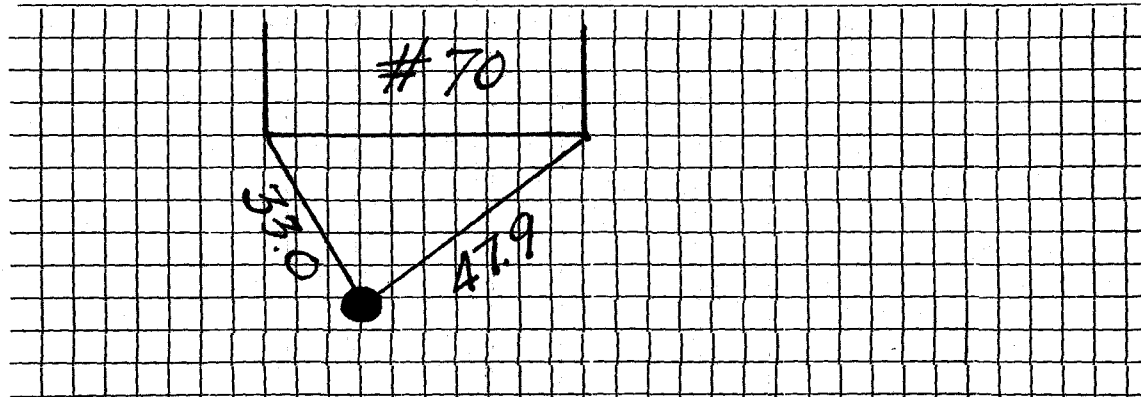

Connection made in Street.

Work completed19

Remarks: