

Name Katherine E. Zimmerman

Service No. 2492

Address 227 Belgrade Ave., Roslindale

# 4889

Location 75 Simonds Road

# 4925

Kind of Pipe

Size

Size of Main

~~Repair-Renewal~~ - New Service

Location

Date

Material

Amount

Total

Date

Amount

*P. 9-18-28  
for  
21.43*

31' 1" C.L. Pipe @.27

8 37

2 1" L.L. 45's @.35

70

3 1" L.L. Ells @.35

1 05

2 1" L.L. Coup. @.25

50

5 1" Br. Sp. Nip. .25

1 25

1 S & W

3 00

Trucking

75

15 62

*Aug. 22 1928 - Cash  
Sept. 20 1928 - Cash*

19 40

2 03

21 43

*8/11/28*

7 Hrs. Labor @.55

3 85

2 " " @.60

1 20

5 05

15% Overhead

76

Labor

21 43

Hadley Press Inc., Lexington

DATE Aug. 27/25

TOWN OF LEXINGTON—BOARD OF PUBLIC WORKS

WATER DIVISION

The undersigned applies for a supply of water at No. 75 Sumner St St. and hereby agrees to comply with the rules and regulations as now, or at any future time, established by the Board of Selectmen.

Am't. of Estimate \$ 19.40<sup>5</sup>


Owner Katherine E Zimmerman

Am't. Paid \$ 19.40

Address 227 Belgrade Ave  
Roslindale Mass A.C.K.

Builder No return

Sketch of Service Here

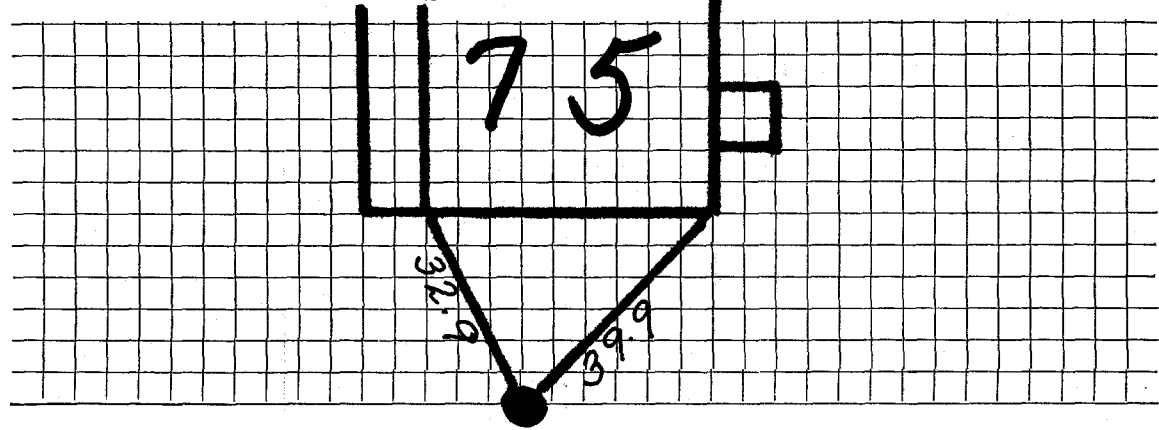

Connection made in \_\_\_\_\_ Street.

Work completed \_\_\_\_\_ 19

Remarks: