




DATE \_\_\_\_\_

TOWN OF LEXINGTON — BOARD OF PUBLIC WORKS

**WATER DIVISION**

Sketch of Service Here

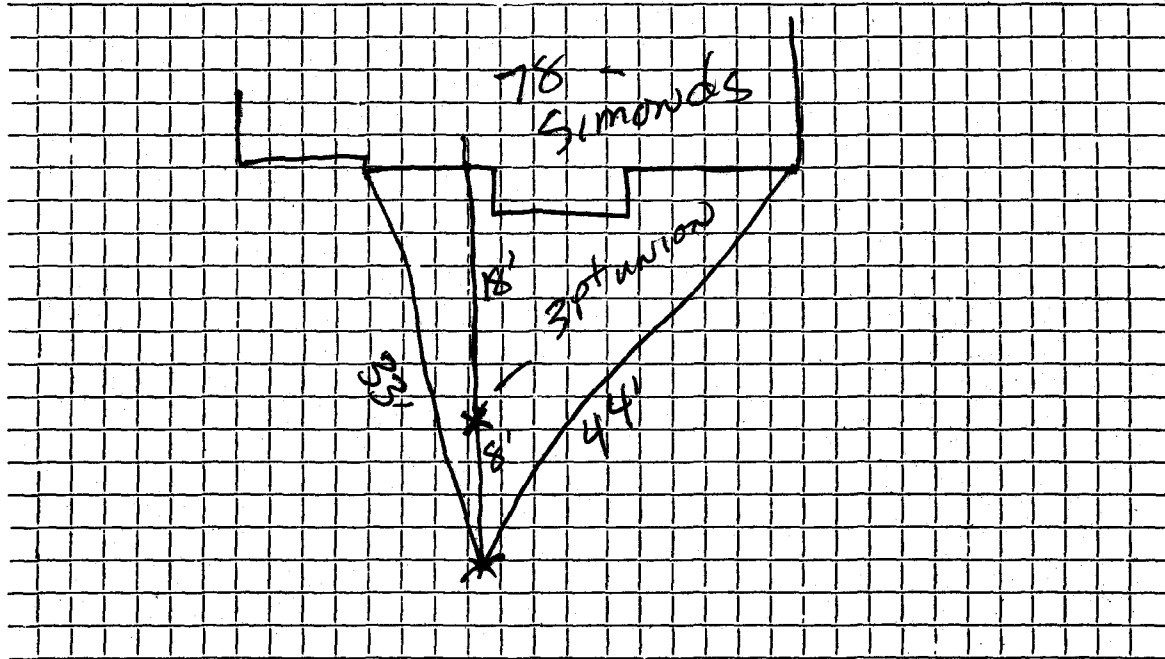

Connection made in ..... Street. Work completed .....

Remarks: .....

.....

.....

Name Winthrop Marks

2262

Service No. 2493

Address 15 Dean St., Everett

78 Simonds Rd.

Location Lots 42, 43 Simonds Road

#78

Kind of Pipe

Size

Size of Main

~~Repair~~ ~~Renewal~~ ~~New Service~~

Location

Date	Material	Amount	Total	Date	Amount
8/9/30	35' 1" C.L. Pipe @.27	9 45			
54.00	2 1" L.L. Coup. @.30	60		Aug. 18 1930 - Cash	54 -
	2 1" L.L. Ells @.35	70			
	2 1" Br. Sp. Nip. @.25	50			
	1 S & W	3 00	14 90		
8/22/30	26 Hrs. Labor @.55	14 30			
	3 " " @.60	1 80	16 10		
	15% Overhead		2 42		
	<b>COST</b>		33 42		
	<b>Labor</b>				
<b>CHARGE</b>	36' @ \$1.50	\$54 00	\$54 00		

Hadley Press, Inc., Kingston

*Lowest side, front vestibule*

DATE July 7, 1930

TOWN OF LEXINGTON—BOARD OF PUBLIC WORKS

**WATER DIVISION**

36  
150  
1800  
36  
54

*Lots 42+43, #7.8*

The undersigned applies for a supply of water at No. Simonds Road and hereby agrees to comply with the rules and regulations as now, or at any future time, established by the Board of Selectmen.

Am't. of Estimate \$ 54

Owner

Winthrop Marks

Am't. Paid \$ 54 - 5-15-30


Address

15 Dean St

Builder Geo. R. Gaudy, Brockton, Mass

Everett Mass

Sketch of Service Here

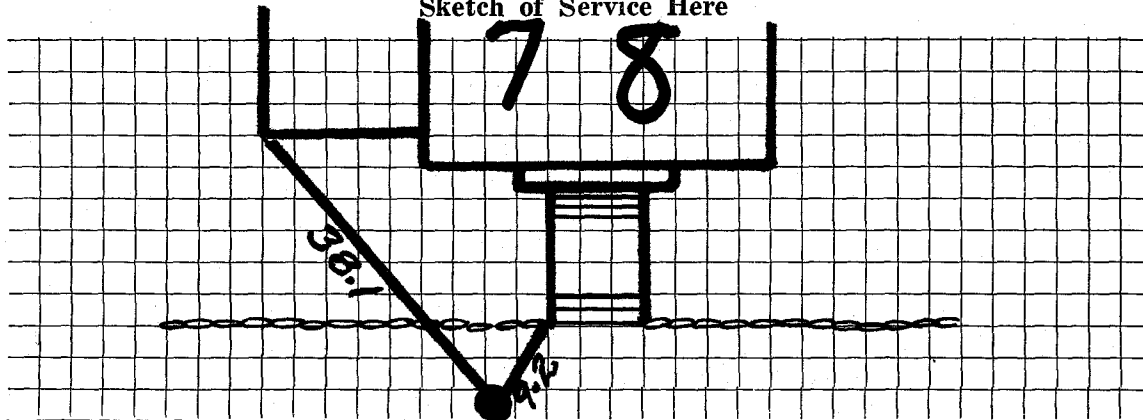

Connection made in \_\_\_\_\_ Street.

Work completed \_\_\_\_\_ 19

Remarks: