

WATER SERVICE RECORD

Name Thomas Moon

Service No. 299

Address 82 Simonds Road

Location Lexington

renewal
~~Repair~~ ~~Service~~ ~~New Service~~

Cont. 11-24-52

Date	Material	Amount	Total	Date		Amount
10/15/52	Labor	1 63				
	10% overhead	16	1 79			
	32' - 3/4" copper tubing@ .34		10 88			
	1 -3/4" C x 1/2 I.W.H. stop & waste		4 00	10/15/52	Labor	1 63
	1 hr. trucking		75		10' -3/4" copper tubing@.34	3 40
			17 42		1 -3/4" C. corp-cock	4 33
					1 -3/4" C x 3/4" C. curb-cock	4 67
					1 box and rod	3 90
					1 -1/2 straight tail piece	50
					1 -1/2 offset tail piece	50
					1 hr. trucking	75
						<u>19 68</u>

20 deposit
11-24-52 Paid 9/2
12-11-52 Paid
NON CHARGE
(3 48)
(13 94)
17 42


bill sent 11-24-52

DATE _____

TOWN OF LEXINGTON — BOARD OF PUBLIC WORKS

WATER DIVISION

Sketch of Service Here

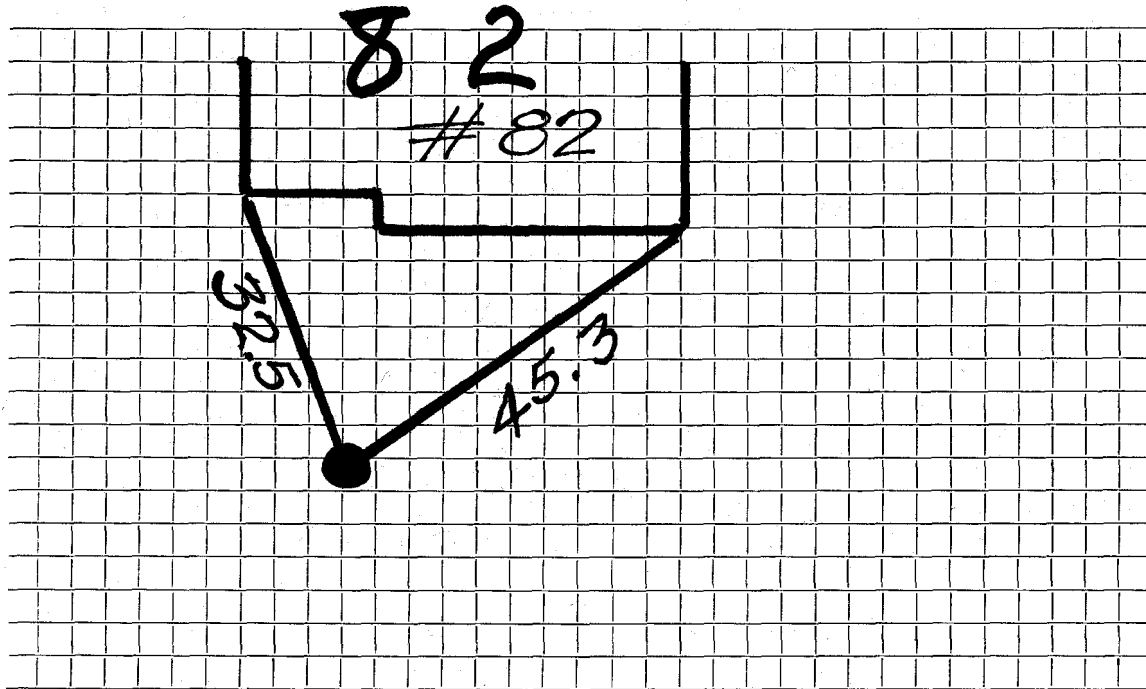

Connection made in Street. Work completed

Remarks:
.....
.....