

WATER SERVICE RECORD

Name **F. Scott Carpenter**

Service No. **354**

Address **83 Simonds Road**

#**3881**

Location **Lexington, Mass.**

~~Repair/Reconnect~~ **New Service**


Com. **12-31-50**

Date	Material	Amount	Total	Date	Amount
Dec. 18, '50	Labor	1 35	1 35	Nov. 28, '50	20 00
	10% Overhead		14	3-29-54	256
	37' - 3/4" Copper Tubing @ .334	12 36			22 56
	1 - 3/4" C x 1/2" I.W.H. S&W	3 76			No Charge
	3 bags of rockwool @ 1.40	4 20		Dec. 18, '50	Labor
	Trucking 1 hr. @ .75	75			1 35
			22 56	31' - 3/4" Copper Tubing @ .334	10 35
				1 - 3/4" C Corp-cock	3 60
				1 - 3/4" C x 3/4" C Curb-cock	4 40
				1 - 3/4" C x 3/4" C Union (3pts)	1 61
				1 - Box & Rod	3 70
				1 - 1/2" Offset Tail Piece	42
				1 - 1/2" Straight Tail Piece	42
				Trucking 1 hr. @ .75	75
					26 60

DATE \_\_\_\_\_

TOWN OF LEXINGTON — BOARD OF PUBLIC WORKS  
WATER DIVISION

Sketch of Service Here

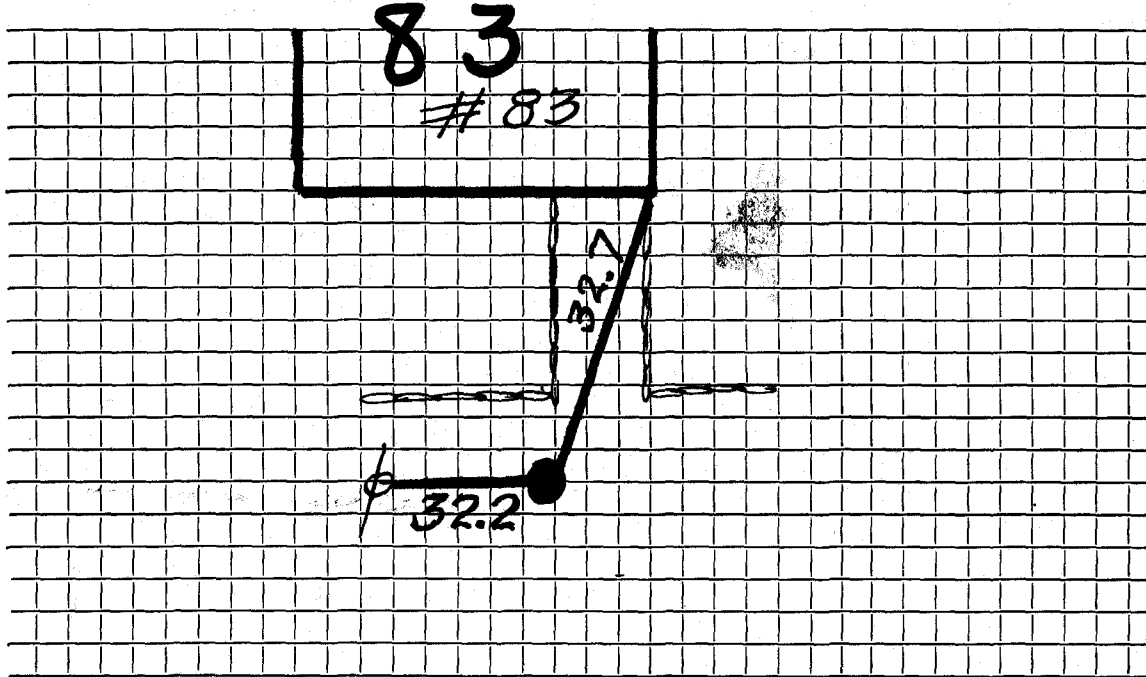

Connection made in ..... Street.      Work completed .....

Remarks: .....  
.....  
.....