

Check from

Name Walter G. Black ( Thomas Moon & Owner)

Service No. 2496

#7388

Address ~~Highland Avenue, Lexington~~

88 Simonds Rd

Location

88 Simonds Road

Kind of Pipe

Size

Size of Main

~~Repair - Renewal~~ New Service

Location

Date	Material	Amount	Total	Date	Amount
April 27, 1940	4 hrs. @ 60¢	2 40		<i>April 23, 1940 Deposited</i> <i>June 11, 1940 Refunded</i>	24 00
<i>Corn 6/11/40</i>	10% Overhead	<u>24</u>	2 64		3 35
	44' 3/4" Copper tubing @ 18¢		7 92		21 65
	1 3/4" C.x 3/4" IS.& W. trucking, 1 hr.		2 25		
	Trench repairs		75		
			<u>4 34</u>		
	Construction Charge		3 75		
			<u>21 65</u>		
	Labor				

Hadley Press, Inc., Lexington

DATE April 23 1971

# TOWN OF LEXINGTON—BOARD OF PUBLIC WORKS

## WATER DIVISION

The undersigned applies for a supply of water at No. 88. Simons Road and hereby agrees to comply with the rules and regulations as now, or at any future time, established by the Board of Selectmen.

Am't. of Estimate \$ 25.00

Owner Thomas Moon


Am't. Paid \$ \_\_\_\_\_

Address Baker Ave

Builder A. G. Blach

Lexington

Sketch of Service Here

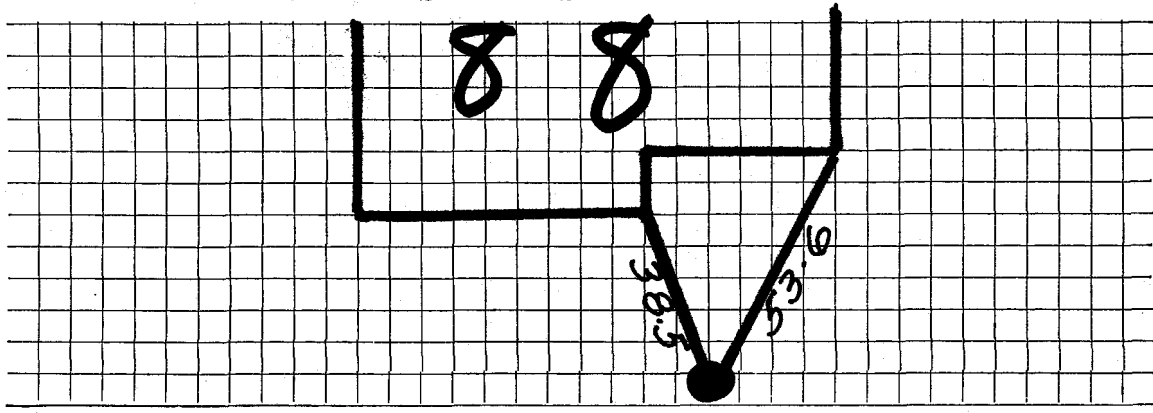

Connection made in \_\_\_\_\_ Street. Work completed \_\_\_\_\_ 19

Remarks: