

Name Walter Black, Builder

Service No. 2497

Address ~~Lots #14 & #15, Simonds Rd.~~

#275

Location #91 House for Kenneth Clarke

Kind of Pipe

Size

Size of Main

~~Repair - Renewal~~ New Service

Location

Date	Material	Amount	Total	Date	Amount
5/23/32	1 # "C.x <sup>3</sup> / <sub>4</sub> " I.S & W	\$2 05			
Com. 2.50	1 # "Copper Connection	75	\$2 80	May 21 1932 - Cash	2 80
6-21-32					
	Labor				

Hadley Press, Inc., Lexington

DATE 5/19/32

TOWN OF LEXINGTON—BOARD OF PUBLIC WORKS

WATER DIVISION

Lot # 14-15

The undersigned applies for a supply of water at No. #91 Sumner St St. and hereby agrees to comply with the rules and regulations as now, or at any future time, established by the Board of Selectmen.

Am't. of Estimate \$ \_\_\_\_\_

Owner

Kenneth Cook

Am't. Paid \$ \_\_\_\_\_


Address

By N S Platt

Builder

owner to dig trench and install 3/4" copper tubing

Sketch of Service Here

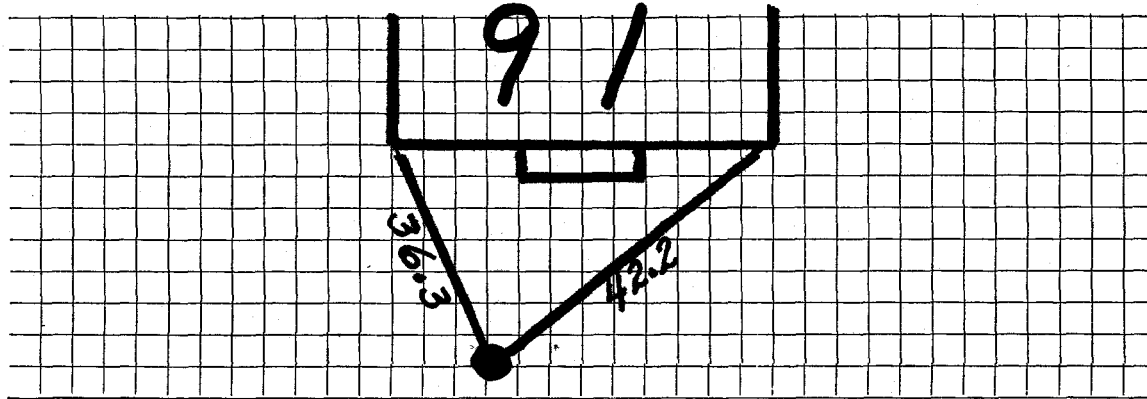

Connection made in \_\_\_\_\_ Street.

Work completed \_\_\_\_\_ 19

Remarks: