


DATE DEC 1984

TOWN OF LEXINGTON — BOARD OF PUBLIC WORKS
WATER DIVISION

Sketch of Service Here

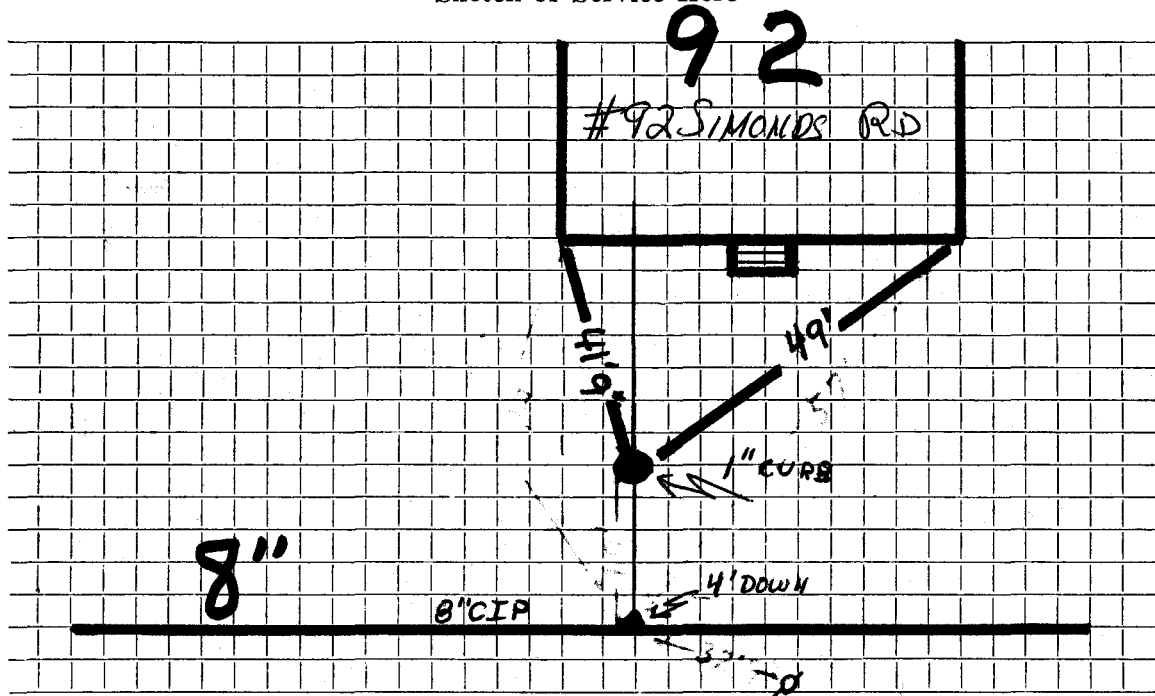

Connection made in SIMONDS RD Street. Work completed MARCH 19, 1985

Remarks:

.....

.....