

Name Stanley E. Cliff (A.C. Sweezy)

Service No. #9 2498

Address ~~Gen. Simonds & Blake Roads~~

#2758

95 Simonds Rd

Location

95 Simonds Rd.

Kind of Pipe

Size

Size of Main

~~Repair~~ New Service

Location

Date

Material

Amount

Total

Date

Amount

1936

March 25

6 hrs. labor @ 55¢

3 30

*Com. 2/12/36  
\$ 11.75  
to Russell*

36' 3/4" Copper @ 16¢

5 76

1 S. & W.

1 75

Trucking

75

11 56

*Oct. 29 1934 Cash*

*11 70*

Say: \$11.70

Labor

261  
45  
130  
104  
---  
411.70

DATE October 29, 1934

# TOWN OF LEXINGTON—BOARD OF PUBLIC WORKS

## WATER DIVISION

The undersigned applies for a supply of water at No. Cor. Blake & Simonds St. and hereby agrees to comply with the rules and regulations as now, or at any future time, established by the Board of Selectmen.

Am't. of Estimate \$ 11.70


Owner D. C. Sweeney

Am't. Paid \$ \_\_\_\_\_

Address 65 Winter St

Builder \_\_\_\_\_

Malden Mass

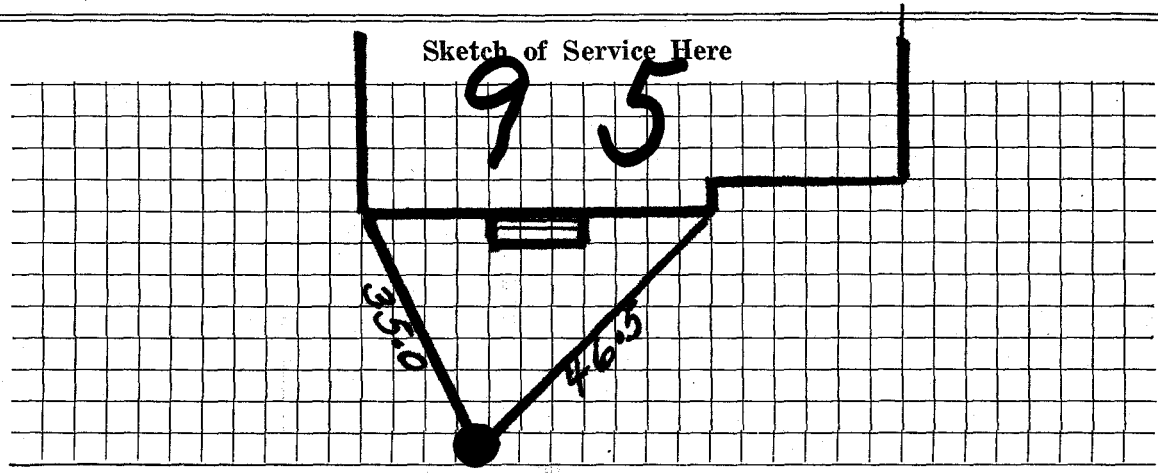

Connection made in \_\_\_\_\_ Street.

Work completed \_\_\_\_\_ 19

Remarks: