

## WATER SERVICE RECORD

Name Anthony Graziano

Service No. 21

Address 12 Skyview Road

Location

Repair—Renewal—New Service *wo # 8630*

JUN 29 1964


Date	Material	Amount	Total	Date	Amount
4/27/64	Labor	7 04		4-3-64	100 00
	10% O.H.	70	7 74	6-28-64	42 21
	39' 3/4" Copper Tubing @ .42	16 38			57 29
	1 3/4" Cx 1/2 I.W.H. Stop & Waste	6 17			
	24 X 3 Patch	24 00	4/27/64	Labor	38 18
	1 Hrs. Trucking @ 3.00	3 00		22' 3/4" Copper Tubing @ .42	9 24
		57 29		1 3/4" C Corp Cock	4 91
				1 3/4" C Curb Cock	6 28
				1 Bow & Rod	4 90
				1 1/2 Straight Tailpiece	50
				1 1/2 Offset Tailpiece	50
					64 51

DATE \_\_\_\_\_

TOWN OF LEXINGTON — BOARD OF PUBLIC WORKS

WATER DIVISION

Sketch of Service Here

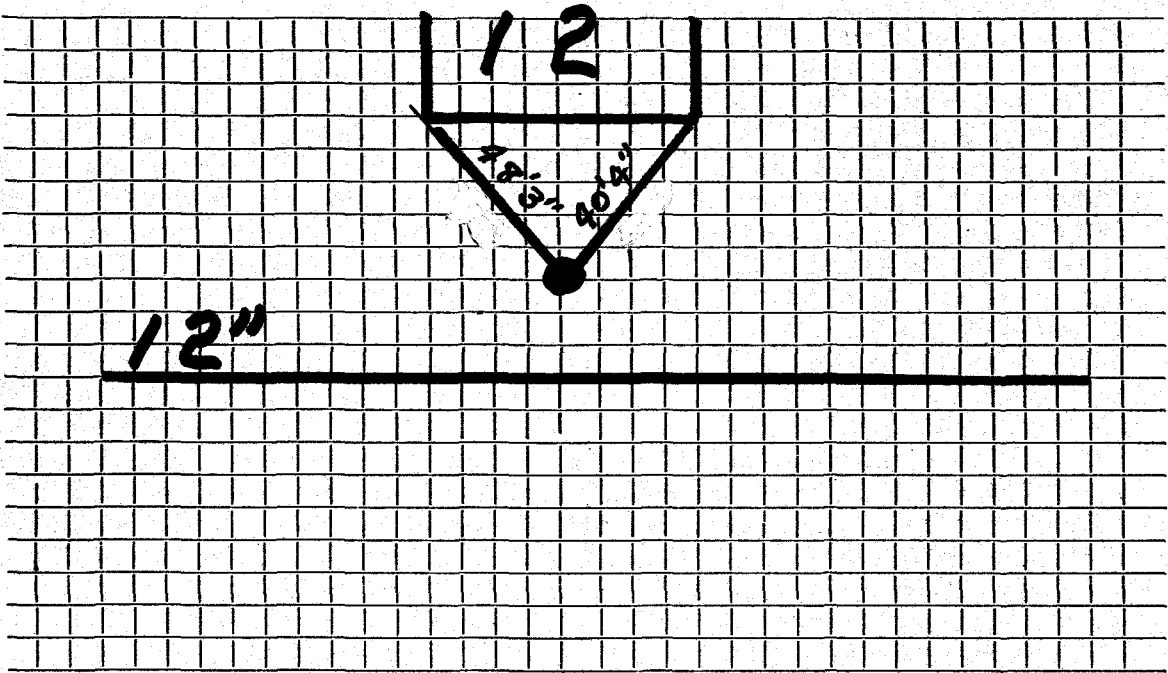

Connection made in ..... Street. Work completed .....

Remarks: .....  
.....  
.....