


DATE 9/24/13

TOWN OF LEXINGTON — BOARD OF PUBLIC WORKS

WATER DIVISION

Sketch of Service Here

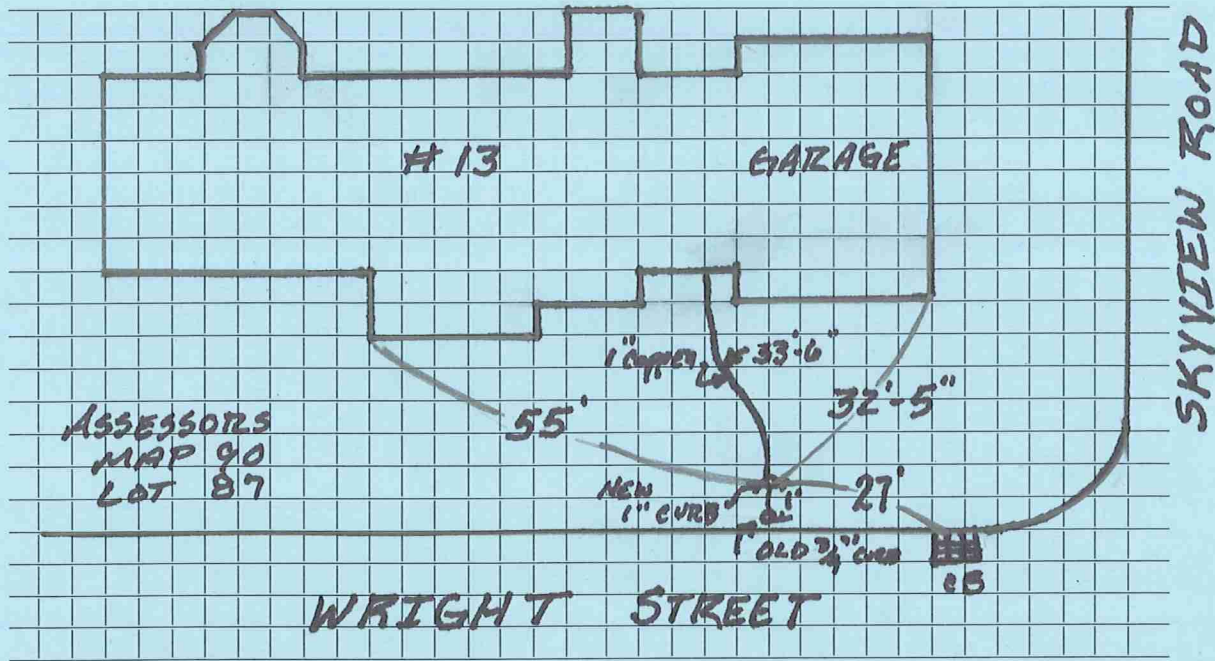

ASSESSORS
MAP 90
LOT 87

WRIGHT STREET

SKYVIEW ROAD

Connection made in Street. Work completed

Remarks: OLD 3/4" CURB BOX REMOVED - OLD 3/4" CURB REMAINED IN

PLACE BURIED AND LEFT OPEN TO USE ← 6" → TO STREET

DEPTH TO WATER SERVICE = 6 FT. NEW 1" CURB 6" OLD 3/4" CURB