

WATER SERVICE RECORD

# 5173

Name Leonard Realty Trust

Service No. 87

Address 17 ~~Street~~ Skyview Road

Location


~~Repair - Renewal~~ - New Service *Com. 6-13-55*

Date	Material	Amount	Total	Date	Amount
4/18/55	Labor	5 05		4-5-55	Deposited 60 00
	10% overhead	51	5 56	6-13-55	Refunded (18 07)
	45' - 3/4" copper tubing @ .3693		16 62		<u>NON CHARGE</u> 41 93
	1 - 3/4" C x 1/2 I.W.H. stop & waste		4 00	4/18/55	Labor 5 05
	2 hrs. Littlefield shovel @ 7.50		15 00		12' - 3/4" copper tubing @ .3693 4 43
	1 hr. trucking		75		1 - 3/4" C. corp-cock 4 33
			41 93		1 - 3/4" C. curb-cock 4 67
					1 box and rod 3 90
					1 - 1/2 straight tail pc. 50
					1 - 1/2 offset tail pc. 50
					1/3 hr. Littlefield shovel @ 7.50 2 50
					1 hr. trucking 75
					<u>26.63</u>

TOWN OF LEXINGTON — BOARD OF PUBLIC WORKS

**WATER DIVISION**

Sketch of Service Here

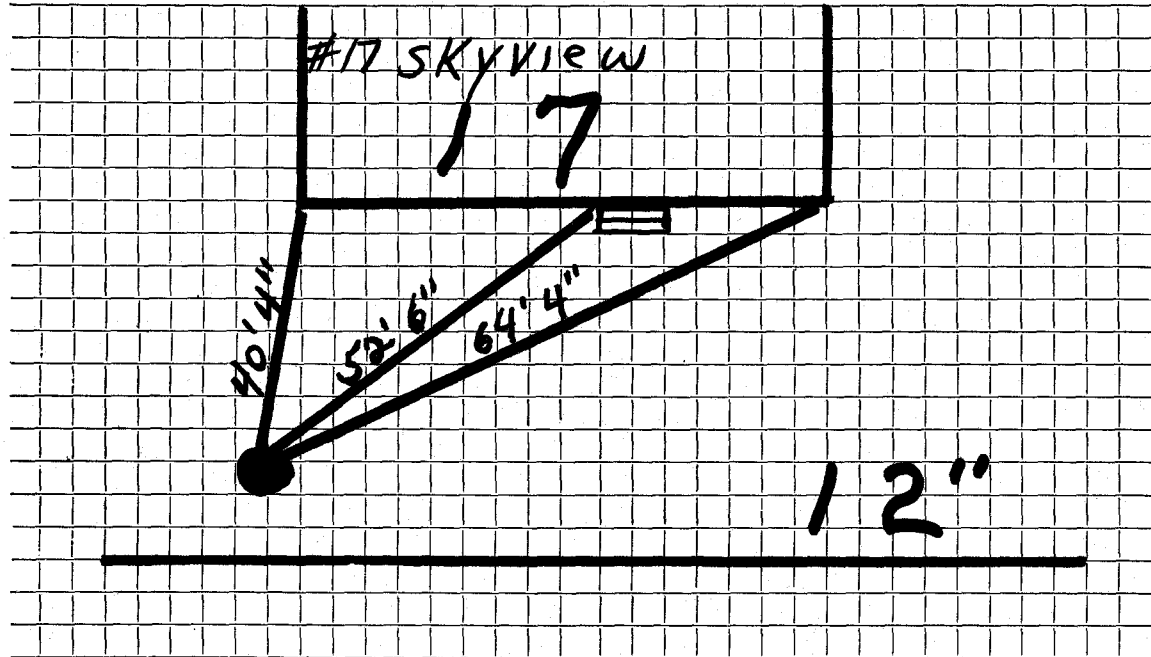

Connection made in ..... Street. Work completed .....

Remarks: .....

.....

.....