

WATER SERVICE RECORD

Name Joseph E. Chishelm

Service No. 275

Address 18 ~~High Street~~

Skyview Road

Location Lexington

~~Repairs Renewal~~—New Service

Comm. 12-3-56


Date	Material	Amount	Total	Date	Amount
9/14/56	Labor	8 67		9-5-56	Deposit 75 00
9/15/56	Labor	11 80		12-3-56	Refund 2 99
	10% Overhead	2 05	22 52		<u>NON CHARGE</u> 72 01
	42' - 3/4" Copper tubing @ .4850	20 37			Labor 3 80
	1 - 3/4" C x 1/2 I.W.H. stop & waste	4 96		24' - 3/4" Copper tubing @ .4850	11 64
	2 hrs. trucking @ .75	1 50		1 - 3/4" C. corp-cock	4 64
	2 2/3 hrs. Littlefield shovel @ 8.50	22 66		1 - 3/4" C. curb-cock	5 94
			72 01	1 box and rod	4 62
				1 hr. Littlefield shovel @ 8.50	8 50
				1 1/2 straight tail piece	50
				1 1/2 offset tail piece	50
					<u>40 14</u>

DATE _____

TOWN OF LEXINGTON — BOARD OF PUBLIC WORKS

WATER DIVISION

Sketch of Service Here

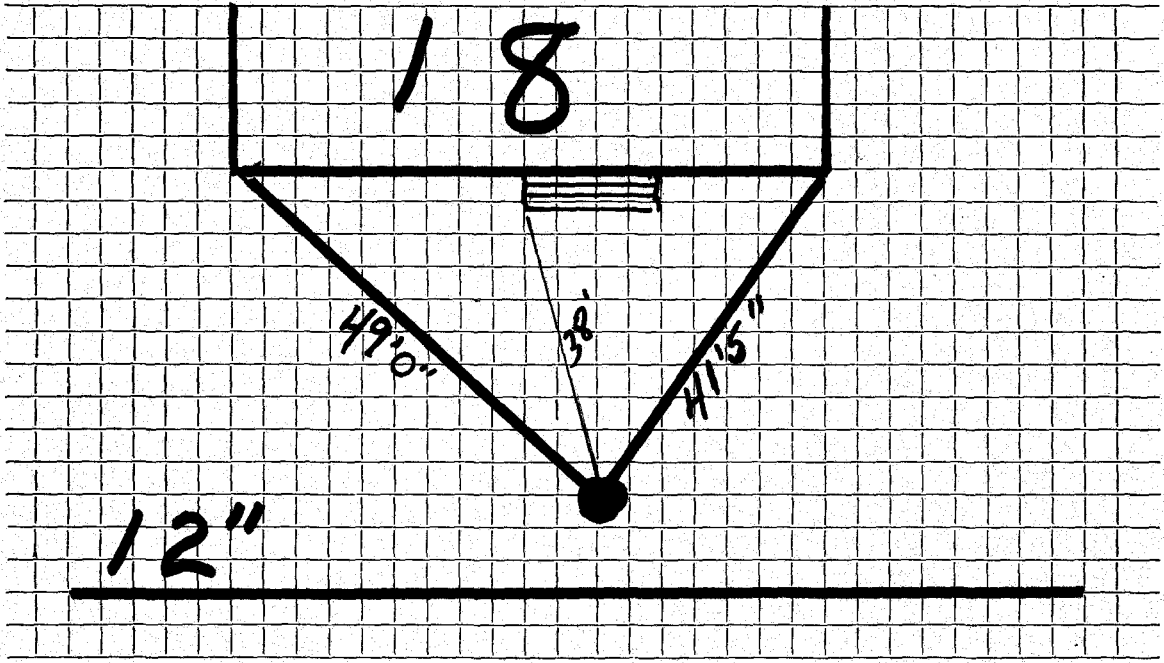

Connection made in Street. Work completed

Remarks:
.....
.....