

#2988

Name Leonard Realty Trust WATER SERVICE RECORD

Service No. 184 #6691

Address 21 ~~High Street~~ Skyview Road

Location


Repair ~~Demolish~~ - New Service *Com. 8-15-55*

Date	Material	Amount	Total	Date	Amount
6/17/55	Labor	6 24		6-20-55 Deposited	60 -
	10% Overhead	62	6 86	8-15-55 Refunded	(25 89
	1 - 3/4" C x 1/2" I.W.H. stop & waste	4 00			NON CHARGE
	3 hrs. Littlefield shovel @ 7.50	22 50	6/17/55	Labor	6 24
	1 hr. trucking		75	12' - 3/4" Copper tubing @ .3693	4 43
			34 11	1 - 3/4" C. corp-cock	4 33
	PIPE SUPPLIED BY OWNER			1 - 3/4" C. curb-cock	4 67
				1 box and rod	3 90
				1 - 1/2" offset tail piece	50
				1 - 1/2" straight tail piece	50
				1/3 hr. Littlefield shovel @ 7.50	2 50
				1 hr. trucking	75
					27 82

TOWN OF LEXINGTON — BOARD OF PUBLIC WORKS

WATER DIVISION

Sketch of Service Here

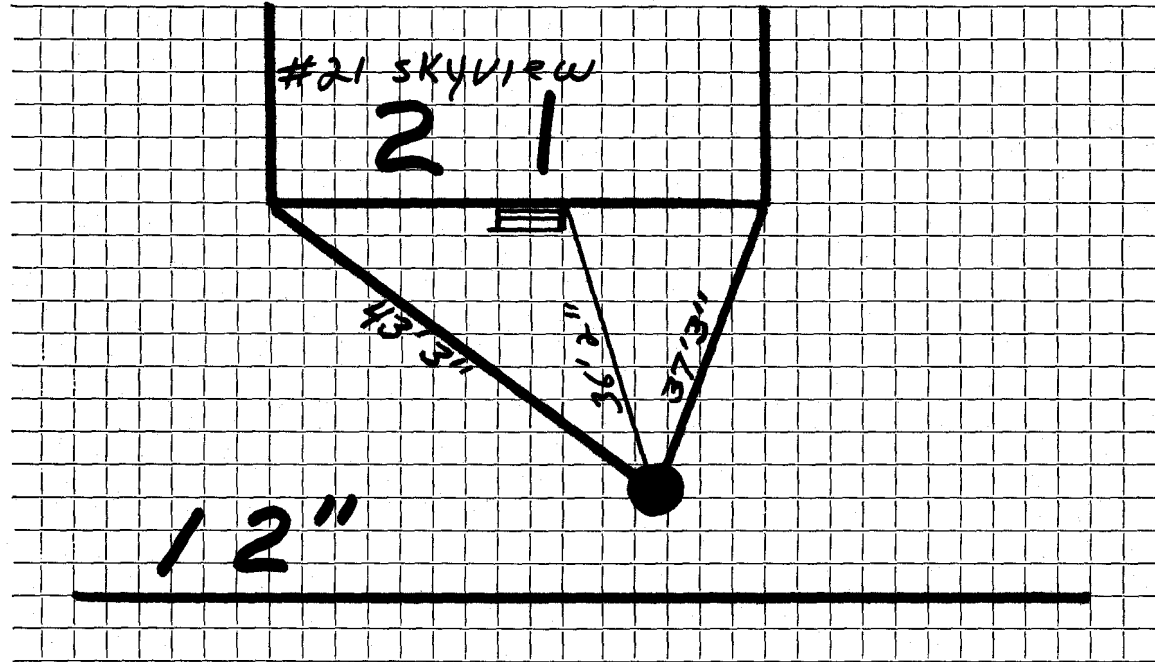

Connection made in Street. Work completed

Remarks:

.....

.....