


DATE _____

TOWN OF LEXINGTON — BOARD OF PUBLIC WORKS
WATER DIVISION

Sketch of Service Here

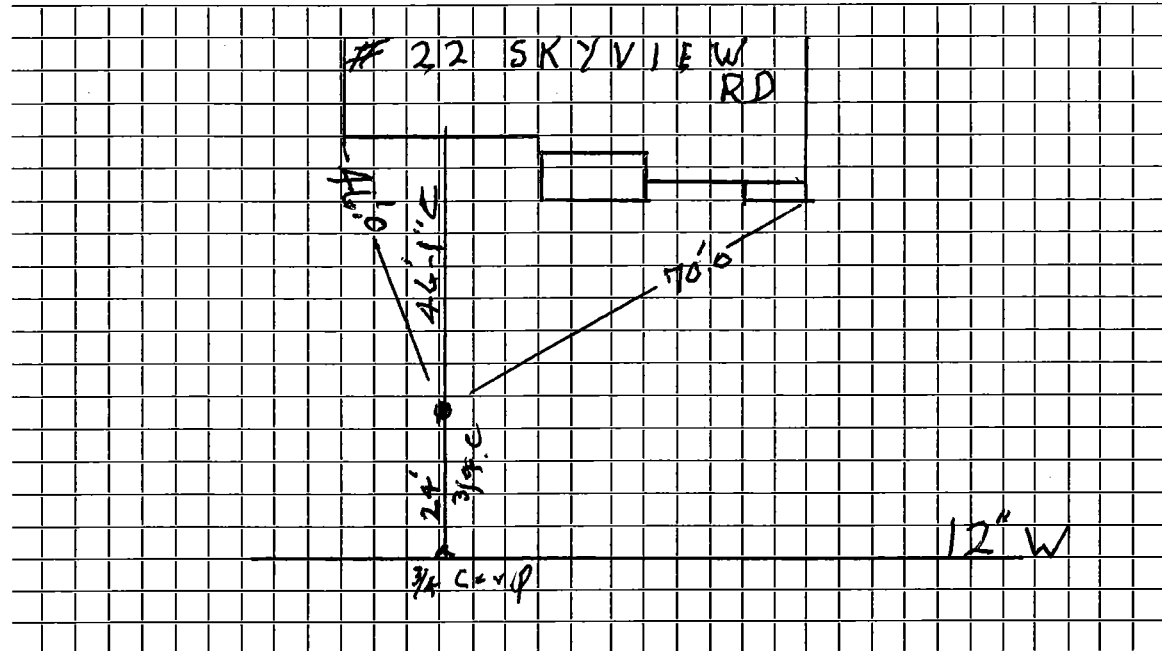

Connection made in Street. Work completed

Remarks: *Ferry Gen. Replaced leaking 3/4" curb stop with 1" curb 9/2010*

.....
.....