

WATER SERVICE RECORD

4857

Name Leonard Realty Trust

Service No. 201

Address 25 ~~Street~~ Skyview Road

Location

~~REPAIR~~ - New Service


COM. 10-10-55

Date	Material	Amount	Total	Date	Amount
7/20/55	Labor	5 96		7-1-55 Deposited	60 00
	10% overhead	60	6 56	10-10-55 Refunded	(26 21)
	39' - 3/4" copper tubing@.384	14 98			33 79
	1 - 3/4"C x 1/2 I.W.H. stop& waste	4 00	7 50	7/20/55 Labor	5 96
	1 hr. trucking		75	13' - 3/4" copper tubing@.384	4 99
	1 hr. Littlefield shovel@ 7.50		7 50	1 - 3/4"C. curb-cock	4 67
			33 79	1 - 3/4"C. corp-cock	4 33
				1 box and rod	3 90
				1 - 1/2 offset tail pc.	50
				1 - 1/2 straight tail pc.	50
				1 hr. trucking	75
				1 hr. Littlefield shovel	7 50
					33 10

TOWN OF LEXINGTON — BOARD OF PUBLIC WORKS

WATER DIVISION

Sketch of Service Here

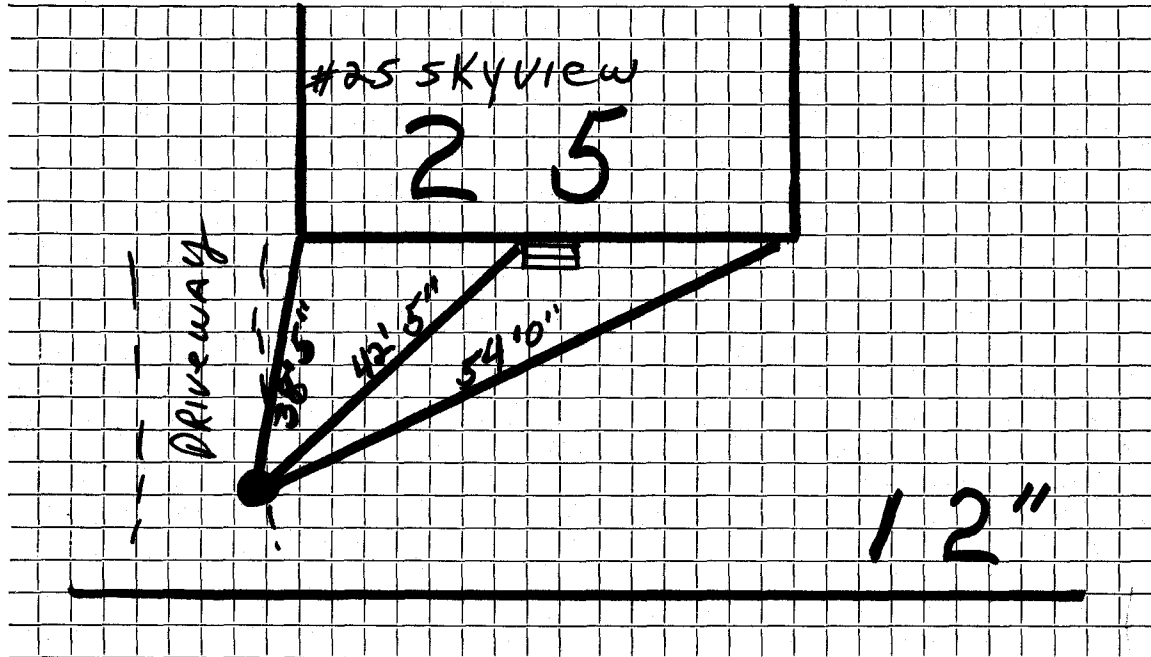

Connection made in Street. Work completed

Remarks:

.....

.....