

WATER SERVICE RECORD

Name Robert Ericson

Service No. 273

Address 32 ~~W. Hill Street~~, Lexington Skyview Road

Location Mail: 46 Shade Street, Lexington

~~Repair - Renewal~~ - New Service


Conn. 11-21-55

Date	Material	Amount	Total	Date	Amount
8/26/55	Labor	5 05		8-18-55 Deposited	75 00
	10% Overhead	51	5 56	11-21-55 Refunded	(31 26)
	48'-3/4" Copper Tubing @ .384		18 43	Non Charge	43 74
	1-3/4" Cx 1/2" I.W.H. stop & waste		4 00	8/26/55 Labor	1 85
	2 hrs. Littlefield Shovel @ 7.50		15 00	14'-3/4" Copper tubing @ .384	5 38
	1 hr. trucking @ .75		75	1-3/4" C. Corp cock	4 33
			43 74	1-3/4" Cx 3/4" C. Curb cock	4 67
				1 Box & Rod	3 90
				1-1/2" straight tail piece	50
				1-1/2" offset tailpiece	50
				1 hr. trucking @ .75	75
					21 88

TOWN OF LEXINGTON — BOARD OF PUBLIC WORKS

WATER DIVISION

Sketch of Service Here

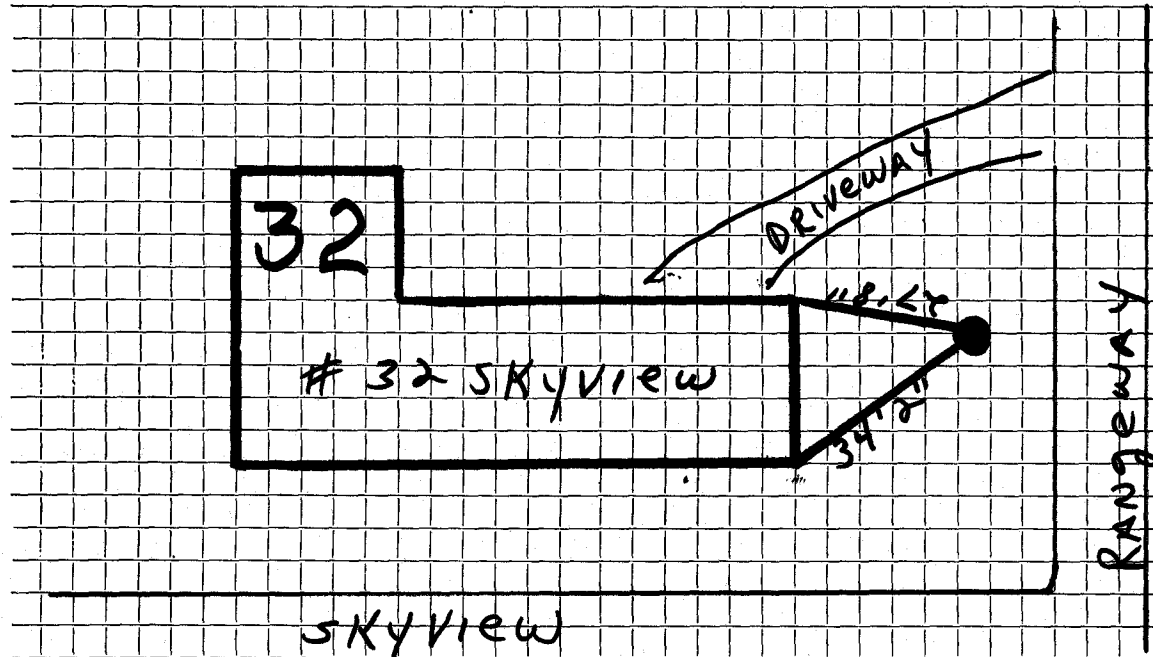

Connection made in Street. Work completed

Remarks:

.....

.....