

Name James Harrison

Service No. 320

Address 33 ~~Harvard Street~~ Skyview Road

Location Lexington, Mass.

~~Repair Work~~ New Service COM. 2-18-52


Date	Material	Amount	Total	Date	Amount
2/7/52	Labor	4 47	4 47	12-7-51 Deposited	30 00
	10% overhead		45	3-27-52 Paid	43
	40' - 3/4" copper tubing @ .3439-13	76			30 43
	1 - 3/4" C x 1/2 I.W.H. stop & waste	4 00			
	1 - hr. Littlefield shovel	7 00		2/7/52 Labor	19 45
	1 hr. trucking		75	15' - 3/4" copper tubing @ .3439	5 16
			30 43	1 - 3/4" C. corp cock	4 33
				1 - 3/4" C x 3/4" C. curb-cock	4 67
				1 - box and rod	4 52
				1 - 1/2 straight tail piece	50
				1 - 1/2 offset tail piece	50
				2 hrs. Littlefield shovel @ 7.00	14 00
				1 hr. trucking	75
					53 88

bill sent 2-19-52

TOWN OF LEXINGTON — BOARD OF PUBLIC WORKS

WATER DIVISION

Sketch of Service Here

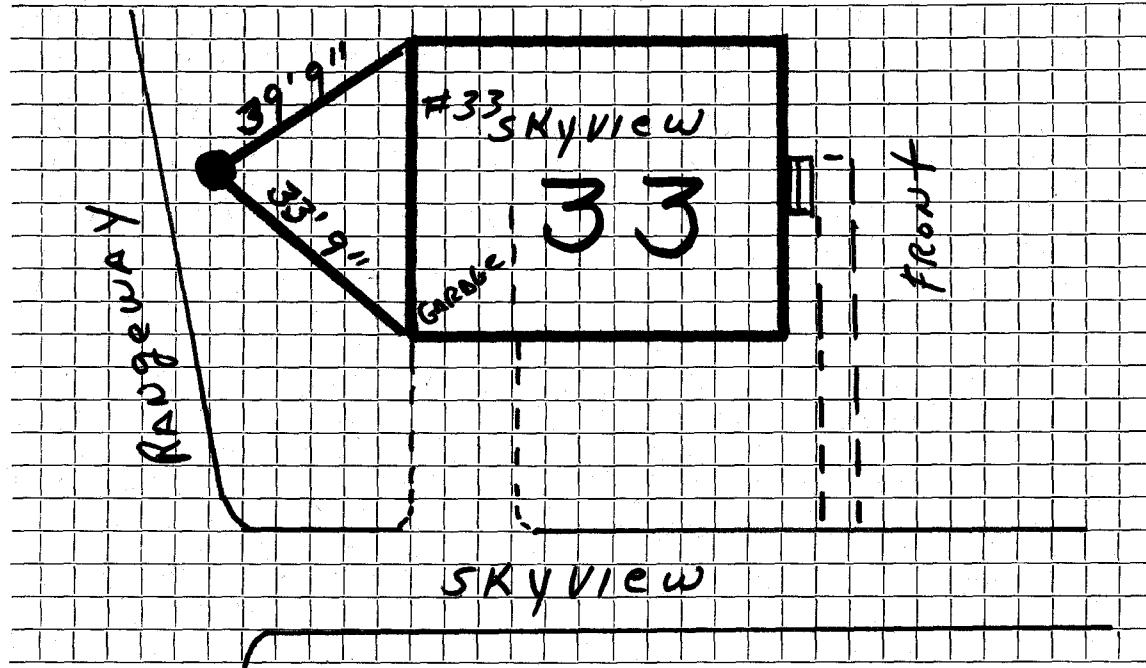

Connection made in Street. Work completed

Remarks:

.....

.....