

## WATER SERVICE RECORD

Name Anthony Graziano

Service No. 20

Address 8 Skyview Road

Location Mail: 20 Thesda St., Arlington, Mass.

~~Repair - Renewal~~ New Service

WO # 8629


JUN 29 1964

Date	Material	Amount	Total	Date	Material	Amount
4/27/64	Labor	7 04		4-3-64	Deposit	100 00
	10% O.H.	70	7 74	4-29-64	Refund	44 81
34'	3/4" Copper Tubing @ .42		14 28			55 19
1	3/4" Cx 1/2 I.W.H. Stop & Waste		6 17			
	24 X 3 Patch		24 00	4/27/64	Labor	38 18-
1	Hr. Trucking @ 3.00		3 00	27'	3/4" Copper Tubing @ .42	11 34
			55 19	1	3/4" C Corp Cock	4 91
				1	3/4" C Curb Cock	6 28
				1	Bow & Rod	4 90
				1	1/2 Straight Tailpiece	50
				1	1/2 Offset Tailpiece	50
				2	Hrs. Town Shovel @ 6.50	13 00
						79 61

TOWN OF LEXINGTON — BOARD OF PUBLIC WORKS

WATER DIVISION

Sketch of Service Here

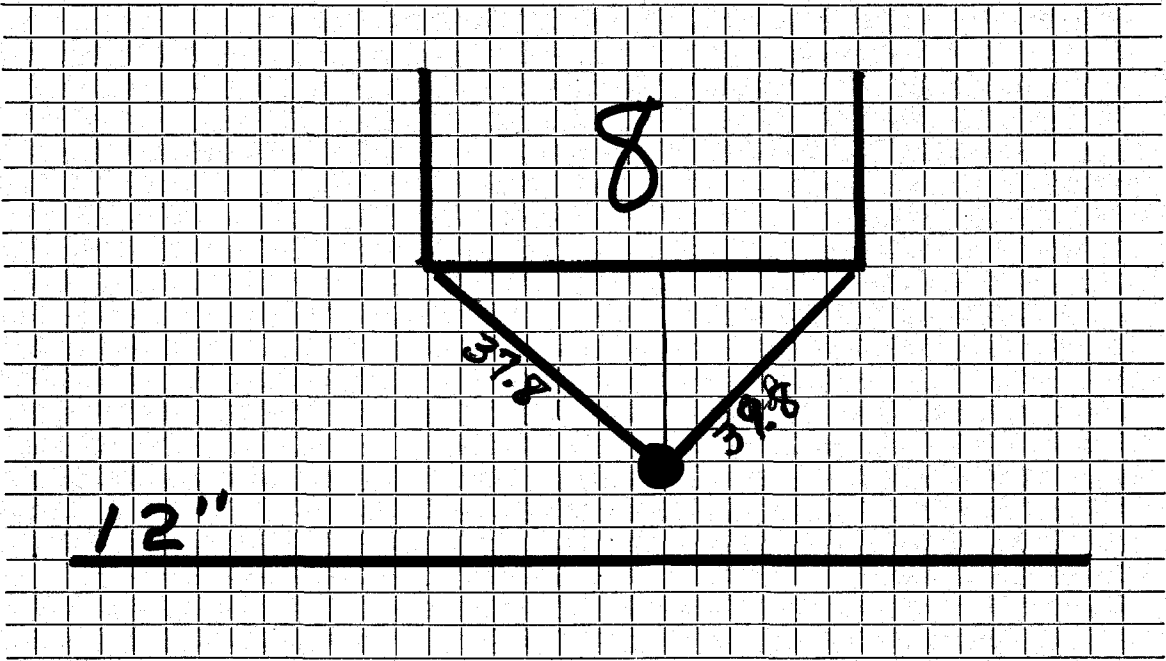

Connection made in ..... Street. Work completed .....

Remarks: .....  
.....  
.....