


DATE 1-19-2018

TOWN OF LEXINGTON — BOARD OF PUBLIC WORKS

WATER DIVISION

Sketch of Service Here

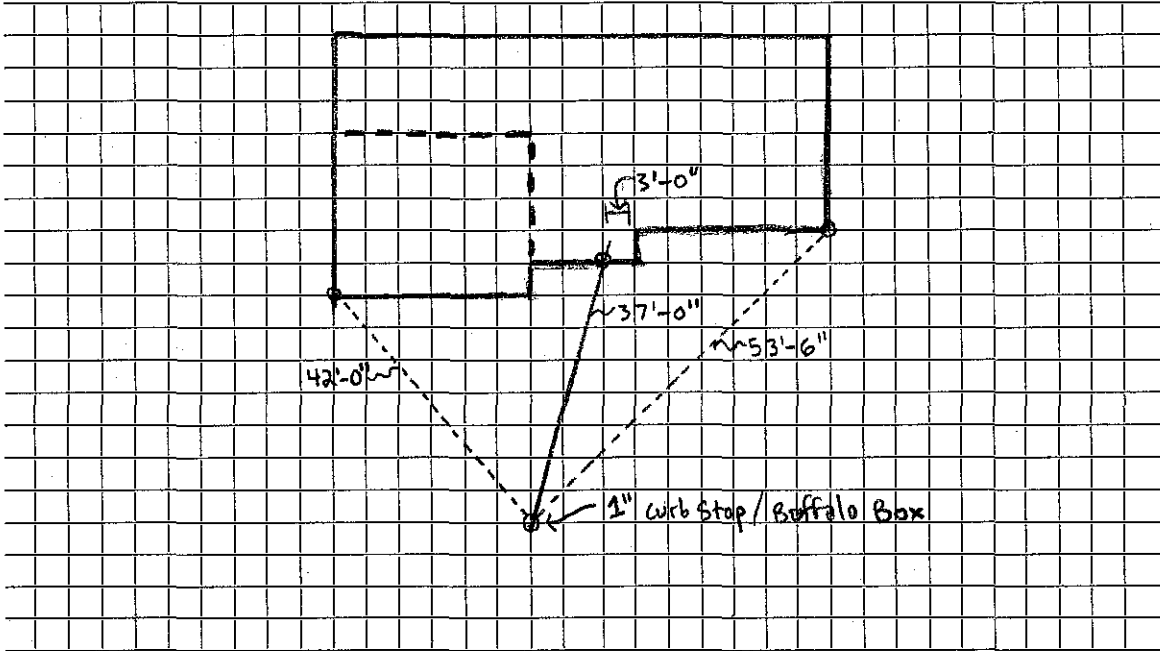

Connection made in 9 Skyview Road Street. Work completed

Remarks: Old Curb Stop was open left (L)