

WATER SERVICE RECORD

Name **Jamed L. Douglass**

Service No. **176**

Address **11 Slocum Road**

Location **Lexington, Mass.**

~~Repair - Renewal~~ - New Service **COM. 10-15-51**


Date	Material	Amount	Total	Date	Amount
9-13-51	Labor	1 49	1 49	7-14-51	Deposited 25 00
	10% Overhead		15	10-15-51	Refunded 2 22
	45'-3/4" Copper Tubing @.326		14.67		No Charge 22 78
	1- 3/4" Cx 1/2" I.W.H. S&W		4 00	9-13-51	Labor 1 49
	1-3/4" Cx 3/4" C. Union (3 Pts)		1 72		6' 3/4" Copper Tubing @.326 1 96
	1 Hr. Trucking		75		1-3/4" C Corp-Cock 4 33
			22 78		1-3/4" Cx 3/4" Curb-Cock 4 67
					1-Box & Rod 4 68
					1-1/2 straight tail piece 50
					1-1/2 offset tail piece 50
					1 Hr. Trucking 75
					18 88

DATE _____

TOWN OF LEXINGTON — BOARD OF PUBLIC WORKS

WATER DIVISION

Sketch of Service Here

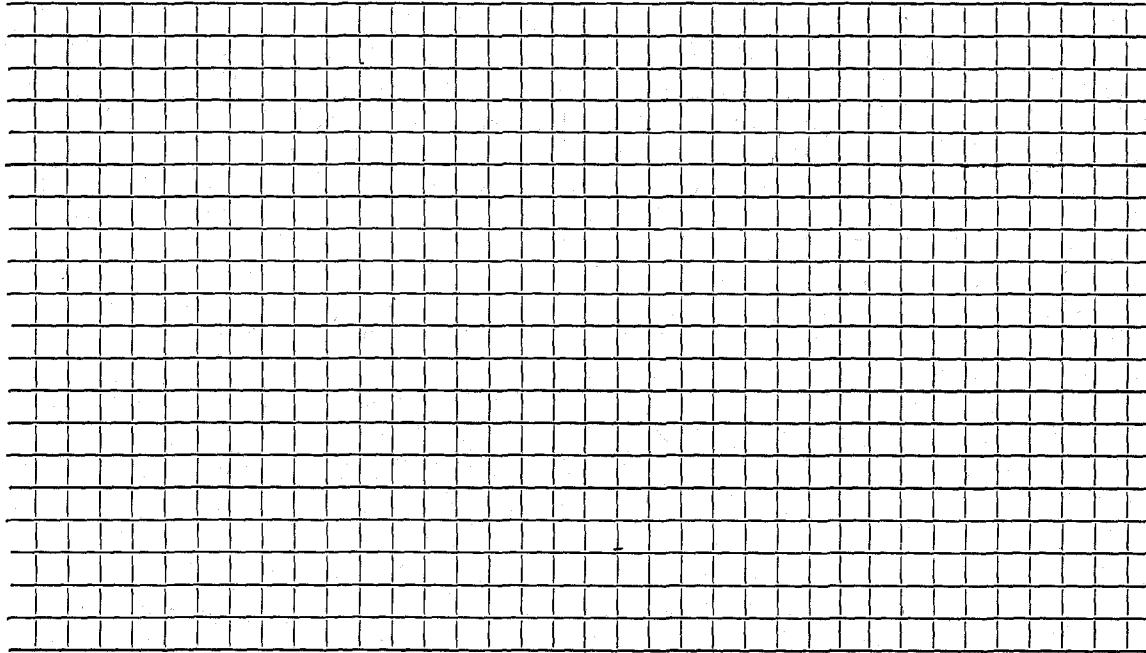

Connection made in Street. Work completed

Remarks:

.....

.....