

WATER SERVICE RECORD

335

Name Alfred Busa

Service No. 91

Address 16 Slocum Road

Location

~~Repair—Renewal—New Service~~


Comm. 9/30/57

Date	Material	Amount	Total	Date	Amount
5/31/57	Labor	2 04		5-16-57	Deposit \$ 50 00
	10% overhead	20	2 24	9-30-57	Refund 26 83
	36' - 3/4" Copper tubing @ .4228	15 22			NON CHARGE 23 17
	1 - 3/4" Cx 1/2 I.W.H. Stop & Waste	4 96	Labor		1 76
	1 hr. Trucking		2 75	23' - 3/4" Copper tubing @ .4228	9 72
			23 17	1 - 3/4" C. Corp Cock	4 64
				1 - 3/4" C. Curb Cock	5 94
				1 Box & Rod	4 62
				1 - 1/2 Straight tailpiece	50
				1 - 1/2 Offset tailpiece	50
					<u>27 68</u>

DATE _____

TOWN OF LEXINGTON — BOARD OF PUBLIC WORKS
WATER DIVISION

Sketch of Service Here

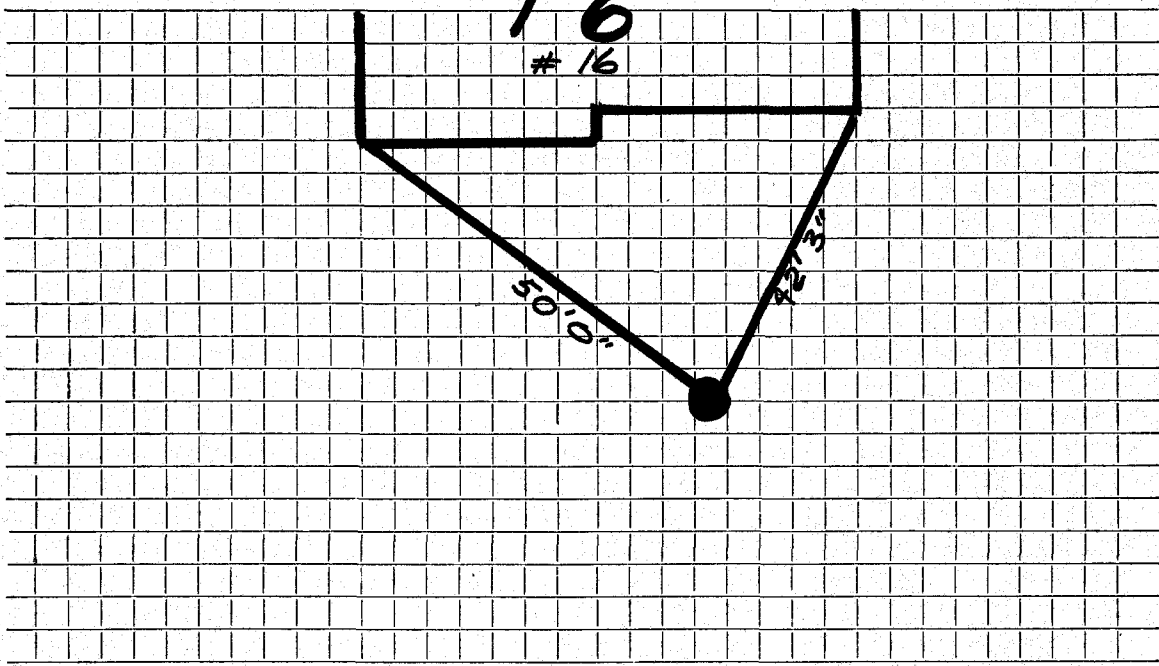

Connection made in Street. Work completed

Remarks:
.....
.....