

WATER SERVICE RECORD

Name John Devine

Service No. 55

Address 19 Slocum Road

Location 19 Slocum Rd.

~~Repair~~—Renewal—~~New Service~~ W.O. #7079

APR 6 1970


Date	Material	Amount	Total	Date	Amount
11/18/69	Labor		39 99	11-16-69	300 00
10	% O.H.		4 00	4-4-70	163 85
55'	1" Copperpipe .99		54 45		136 85
1	1" Wheel Valve		12 01		
3	Yds. Loam 3.50		10 50		
					<u>OUTSIDE</u>
1	Hr. trucking		3 00	11/18/69	Labor 66 65
2	" shovel 6.50		13 00	12/10/69	" 26 19
			136 95	6'	1" Copperpipe .99 5 94
				1	1" Curb cock 14 43
				1	1" Adaptor 2 76
				1/4	Box & Rod 5 10
				1	Ton cold patch 5.85 1 46
				1	Ton hot top 5 85
				2 1/2	Hrs. trucking 3.00 7 50
				1	" " 1 50
				2	" shovel 4.00 8 00
				2	" compressor 5.00 2 50
				1	roller 3.00 1 50
					trailer 2 00
					<u>151 38</u>

DATE _____

TOWN OF LEXINGTON -- BOARD OF PUBLIC WORKS

WATER DIVISION

Sketch of Service Here

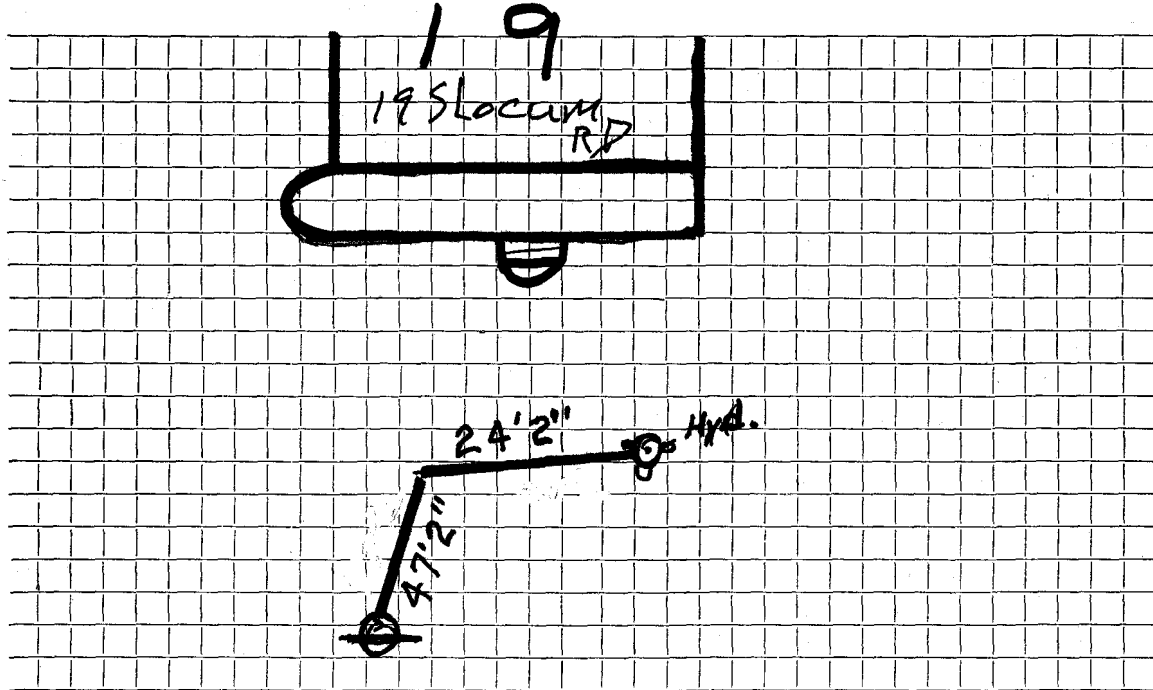

Connection made in Slocum Rd Street. Work completed

Remarks:
.....
.....