

WATER SERVICE RECORD

Name **Walter Black**

Service No. 196

Address **201 Slocum Road**

Location **Lexington**

~~Repair Request~~ **New Service**

Com. 9-29-52


| Date | Material | Amount | Total | Date | Amount |
|--------|--------------------------|--------|-------|-------------------------------------|-------------------|
| 9/3/52 | Labor | 20 00 | | 9-4-52 Deposited | 30 00 |
| | 10% Overhead | 2 00 | 22 00 | 9-29-52 Refunded | (2 93 |
| | 3' - 2" C.L. Pipe @.7745 | | 2 32 | | <u>NON CHARGE</u> |
| | 1 hr. Littlefield shovel | | 7 00 | 9/3/52 Labor | 33 10 |
| | 1 hr. trucking | | 75 | 24' - 2" C.L. Pipe @.7745 | 18 58 |
| | patching 15 X 3 | | 15 00 | 20' - 1" Copper tubing@.3997 | 7 99 |
| | | | 47 07 | 4 - 1" C. Corp-cock | 5 61 |
| | | | | 1 - 1" C x 2" I.4 way branch | 19 38 |
| | | | | 1 - 2" T.H. Gate Valve | 12 50 |
| | | | | 2 - 2" x 1 1/2 L.L. Couplings @1.85 | 3 70 |
| | | | | 2 - 1 1/2 Nipples 6" long@.45 | 90 |
| | | | | 1 Gate-Box | 14 25 |
| | | | | 1 Pit Cover & frame | 8 71 |
| | | | | 500 Cement Brick @20.00 M | 10 00 |
| | | | | 2 hr. Littlefield shovel @.7 | 14 00 |
| | | | | 1 hr. trucking | 75 |
| | | | | | 149 47 |

DATE _____

TOWN OF LEXINGTON — BOARD OF PUBLIC WORKS

WATER DIVISION

Sketch of Service Here

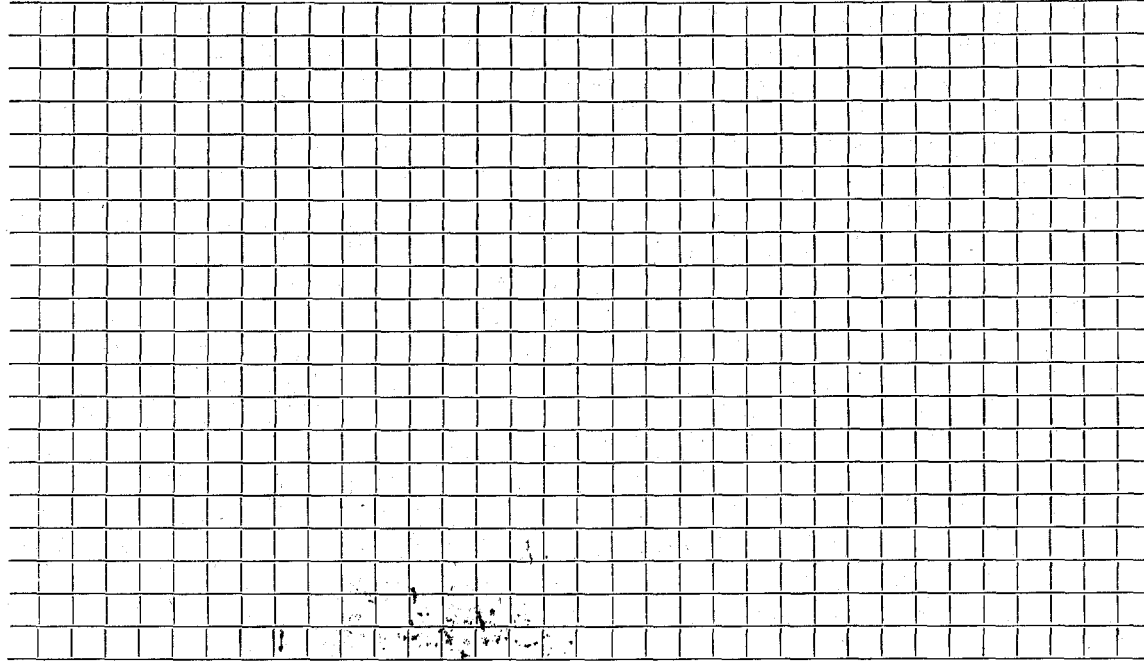

Connection made in Street. Work completed

Remarks:
.....
.....