

**WATER SERVICE RECORD**

Name *William Krag*

Service No. *35*

Address *22 Slocum Road*

# *4928*

Location

~~RENEWAL~~ - Renewal - ~~DISCONTINUED~~ *W.O. #7934*

*Comm 8-26-63*


Date	Material	Amount	Total	Date		Amount
<i>6-10-63</i>	<i>Labor</i>	<i>2.31</i>		<i>5-15-63</i>	<i>Deposit</i>	<i>50.00</i>
	<i>10% O.H.</i>	<i>.23</i>	<i>2.54</i>	<i>8-26-63</i>	<i>Refund</i>	<i>18.72</i>
<i>48'</i>	<i>3/4" Copper tubing @.42</i>		<i>20.16</i>			<i>31.28</i>
<i>1</i>	<i>3/4" C x 1/2" I.W.H. Stop &amp; Waste</i>		<i>6.17</i>		<i>NON CHARGE</i>	
<i>1</i>	<i>3/4" G 3 part union</i>		<i>2.41</i>			
			<i>31.28</i>	<i>6-10-63</i>	<i>Labor</i>	<i>2.31</i>
				<i>19'</i>	<i>3/4" Copper tubing @.42</i>	<i>7.98</i>
				<i>1</i>	<i>3/4" C Curb Cock</i>	<i>6.28</i>
				<i>1</i>	<i>Box &amp; Rod</i>	<i>4.90</i>
				<i>1</i>	<i>1/2" Straight tailpiece</i>	<i>.50</i>
				<i>1</i>	<i>1/2" Offset Tailpiece</i>	<i>.50</i>
						<i>22.17</i>
					<i>Apply 2.00 to SHC # 44</i>	

DATE \_\_\_\_\_

TOWN OF LEXINGTON — BOARD OF PUBLIC WORKS

**WATER DIVISION**

Sketch of Service Here

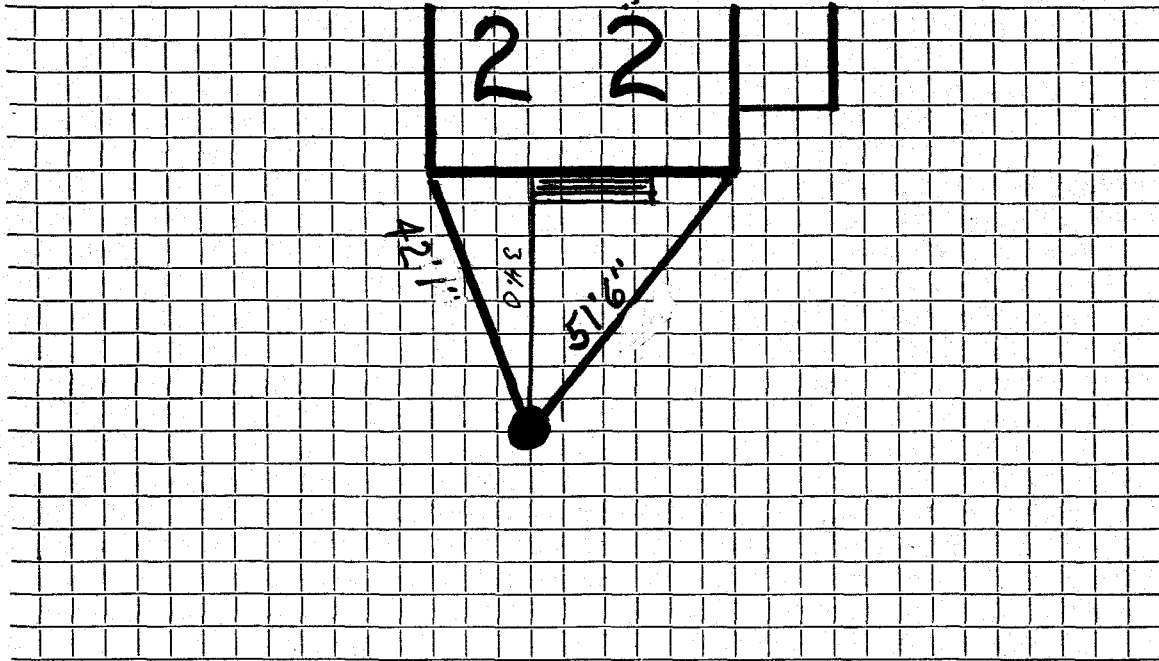

Connection made in ..... Street. Work completed .....

Remarks: .....

.....

.....