


Water Service Tie Card
TOWN OF LEXINGTON
 MASSACHUSETTS

26 Slocum Rd

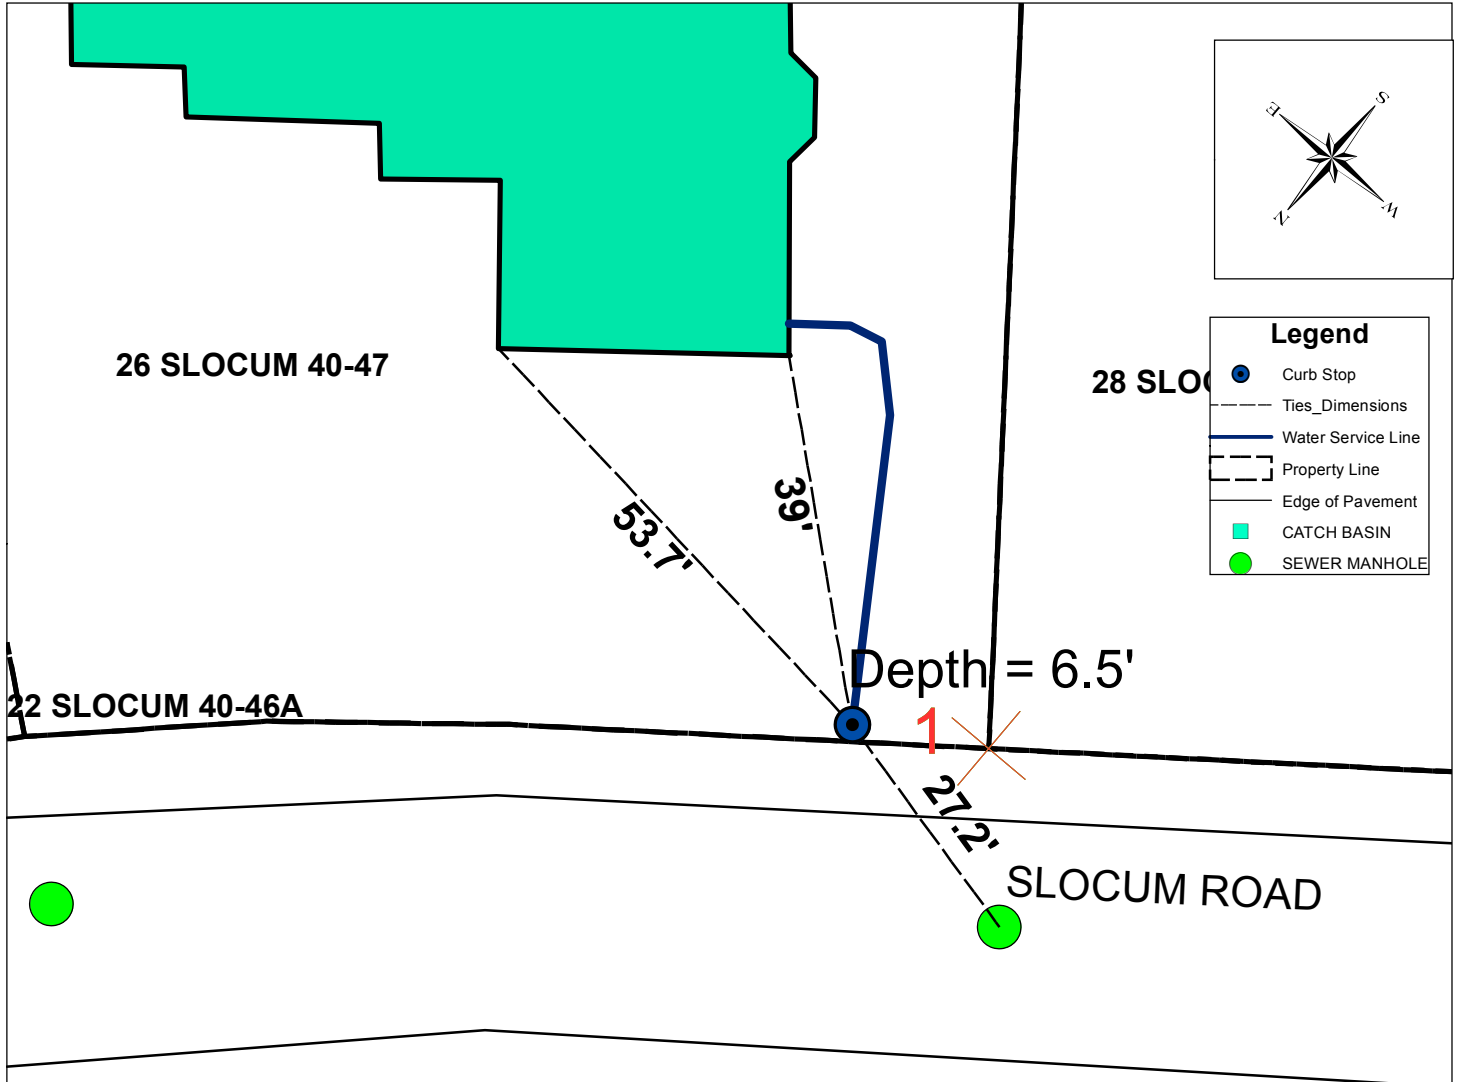

Address	Map and Lot	Permit Number	Contractor Name	Inspector
26 Slocum Rd	40-47	5804	McLaughlin, James M. Inc.	dpavlik
Date	Material	Depth of Cover	Amount	
12/26/2014	1" Curb Valve and Buffalo Box	6.5 ft	1	
	1" Copper type "k"	5 ft	50 ft to HSE	
Type of work completed				

New 1" water service to house from curb stop. New house on lot old house removed.