

WATER SERVICE RECORD

1026

Name *Helen Murphy*

Service No.

Address *27 Slocum Road*

Location

Repair ~~General New Service~~ W.O #816 *Frank Kirkland #3920*


Date	Material	Amount	Total	Date	Amount
8-11-65	Labor	45.28			
	10% O.H.	4.53	49.81		
	10' 3/4" Copper tubing @42		4.20		
	8 x 3 Patch		8.00		
	1 Adapter		2.76		
	1 3/4" Coupling		3.01		
	1 3/4" Curb		8.76		
	1 hr. Town Truck		3.00		
	2 hrs. Tractor @6.50		13.00		
			92.54		
	Renewal				
11/14/84	45' 3/4" Copper tubing				

DATE _____

TOWN OF LEXINGTON — BOARD OF PUBLIC WORKS

WATER DIVISION

Sketch of Service Here

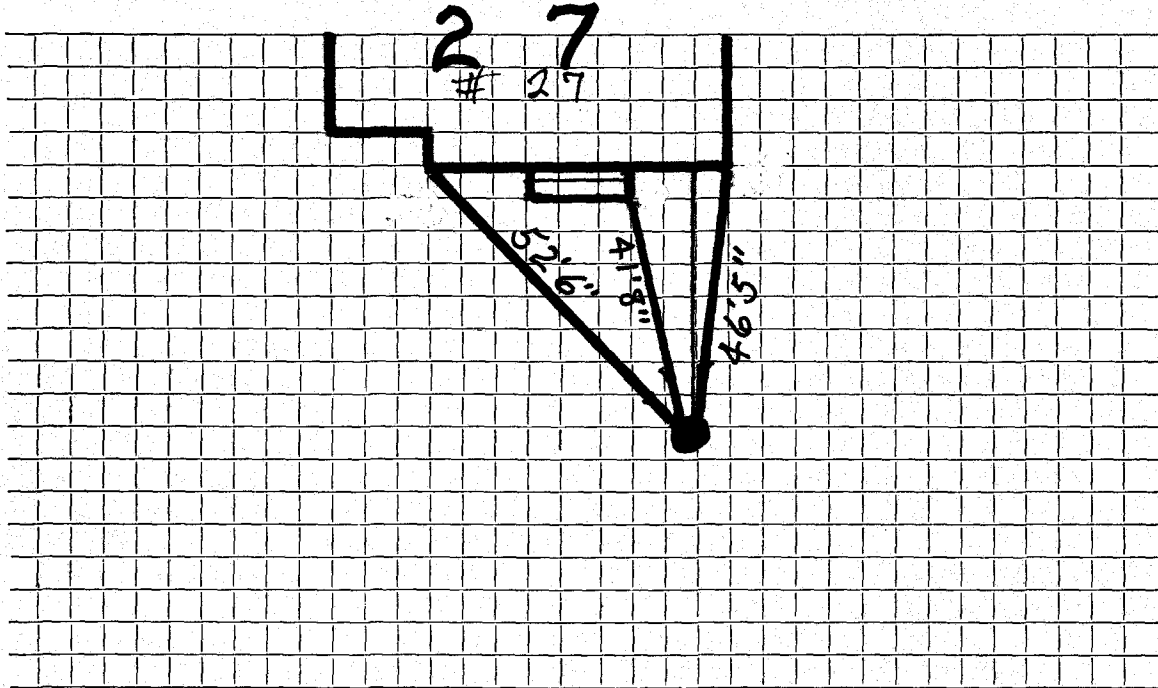

Connection made in Street. Work completed

Remarks:
.....
.....