

Name O'Connor & Quinn

2980

Service No. 50 2511

Address Cor. Slocum Road & Highland Ave.

31 Slocum Rd.

8809

31 Slocum Rd.

Location ~~1874 Mass. Ave., Cambridge~~

Kind of Pipe

Size

Size of Main

~~Repair-Renewal~~ - New Service

Location

Date	Material	Amount	Total	Date	Amount
	49' 1" C.L. Pipe @.27	13 23			
	2 1" L.L. Coup. @.30	60			
	1 1" L.L. Ell	35			
	1 1" Br. Sp. Nipple	25			
	1 S & W	3 00			
	Trucking	75	18 18		
	98 Hrs. Labor @.55	53 90			
	4 " " @.60	2 40	56 30		
	15% Overhead		8 45		
			82 93		
	Labor is for water and sewer services				

Oct. 19 1929 - Cash

82 93

P.R. 4-29
Lor
8293

Hadley Press, Inc., Lexington

DATE June 19, 1929

TOWN OF LEXINGTON—BOARD OF PUBLIC WORKS

WATER DIVISION

The undersigned applies for a supply of water at No. 31 Highland Ave. & Slocum Rd. St. and hereby agrees to comply with the rules and regulations as now, or at any future time, established by the Board of Selectmen.

Am't. of Estimate \$ _____

Owner

O'Connor & Quinn


Am't. Paid \$ _____

Address

1374 Mass Ave
Cambridge

Builder _____

Sketch of Service Here

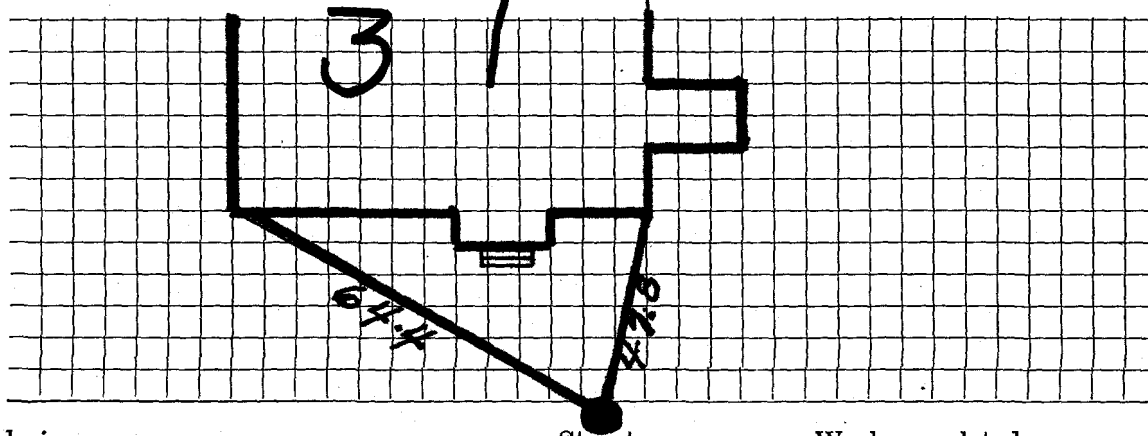

Connection made in _____

Street.

Work completed _____

19

Remarks: