

## WATER SERVICE RECORD

Name

Service No.

Address 32 Slocum Road

Location


Repair—~~WATER SERVICE~~ W.O. #2159

Date	Material	Amount	Total	Date	Amount
4-7-27					
	39½ 1" Gal. Pipe			4/28/66	CURB TO MAIN Labor 101.15
	2 1" Elbs			5/2/66	Patch 14.24
	2 1" Nipples			5/3/66	Patch 21.44
	1 Stop & Waste				10% O.H. 13.68
				1	1" x 4 nipple 74
				1	1" clamp 26
				1	¾" curb 876
				19'	¾" copper @.70 1330
				1	¾ adapter 276
				¼	Ton cold patc h @5.00 125
					Loam & seed
				1½	Ton Hot top @ 5.50 725
				4	Hrs truck @ 3.00 1200
				3	Hrs tractor @ 6.50 1950
				½	Hr trailer @ 2.00 100
				½	Hr. roller @ 3.00 150
					220 83

DATE \_\_\_\_\_

TOWN OF LEXINGTON — BOARD OF PUBLIC WORKS  
WATER DIVISION

Sketch of Service Here

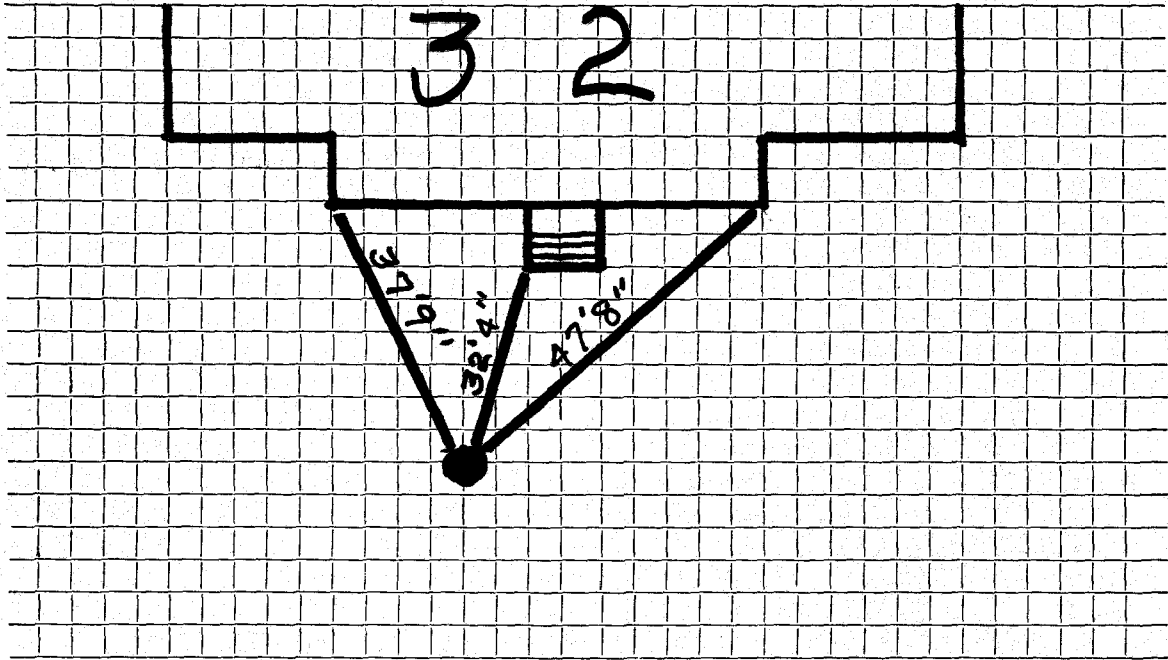

Connection made in ..... Street. Work completed .....

Remarks: *Original Service 4-7-27* .....

.....  
.....