




DATE \_\_\_\_\_

TOWN OF LEXINGTON — BOARD OF PUBLIC WORKS

WATER DIVISION

Sketch of Service Here

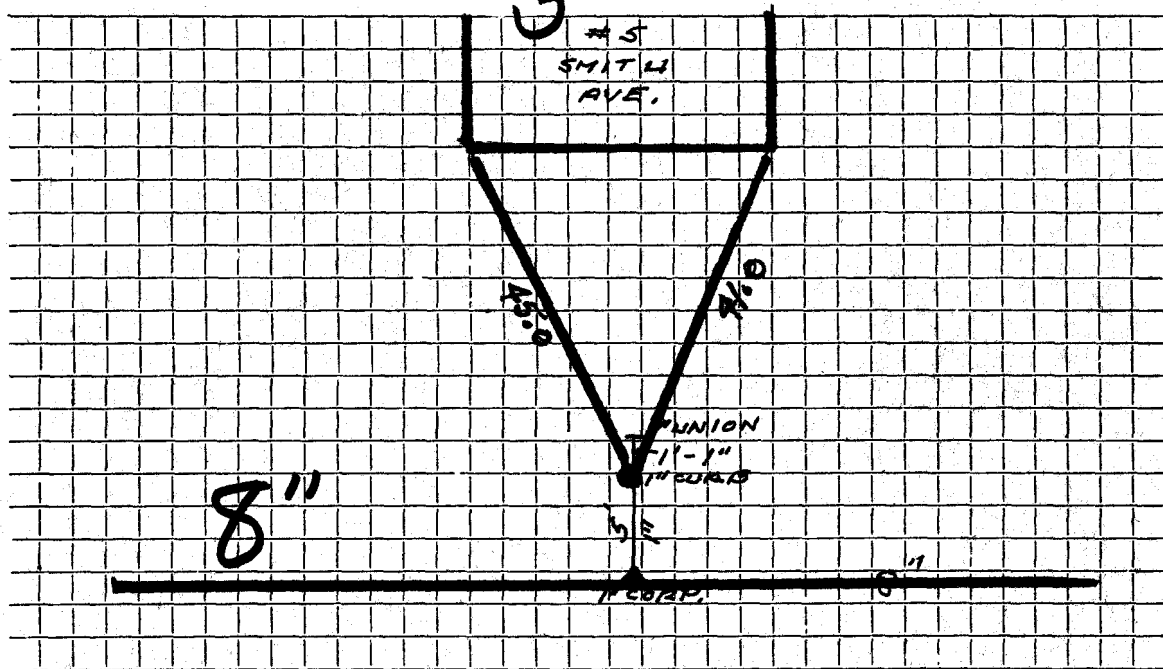

Connection made in SMITH AVE. Street. Work completed .....

Remarks: EXISTING SERV. 1" IRON .....