


DATE _____

TOWN OF LEXINGTON — BOARD OF PUBLIC WORKS

WATER DIVISION

LOT # 22

Sketch of Service Here

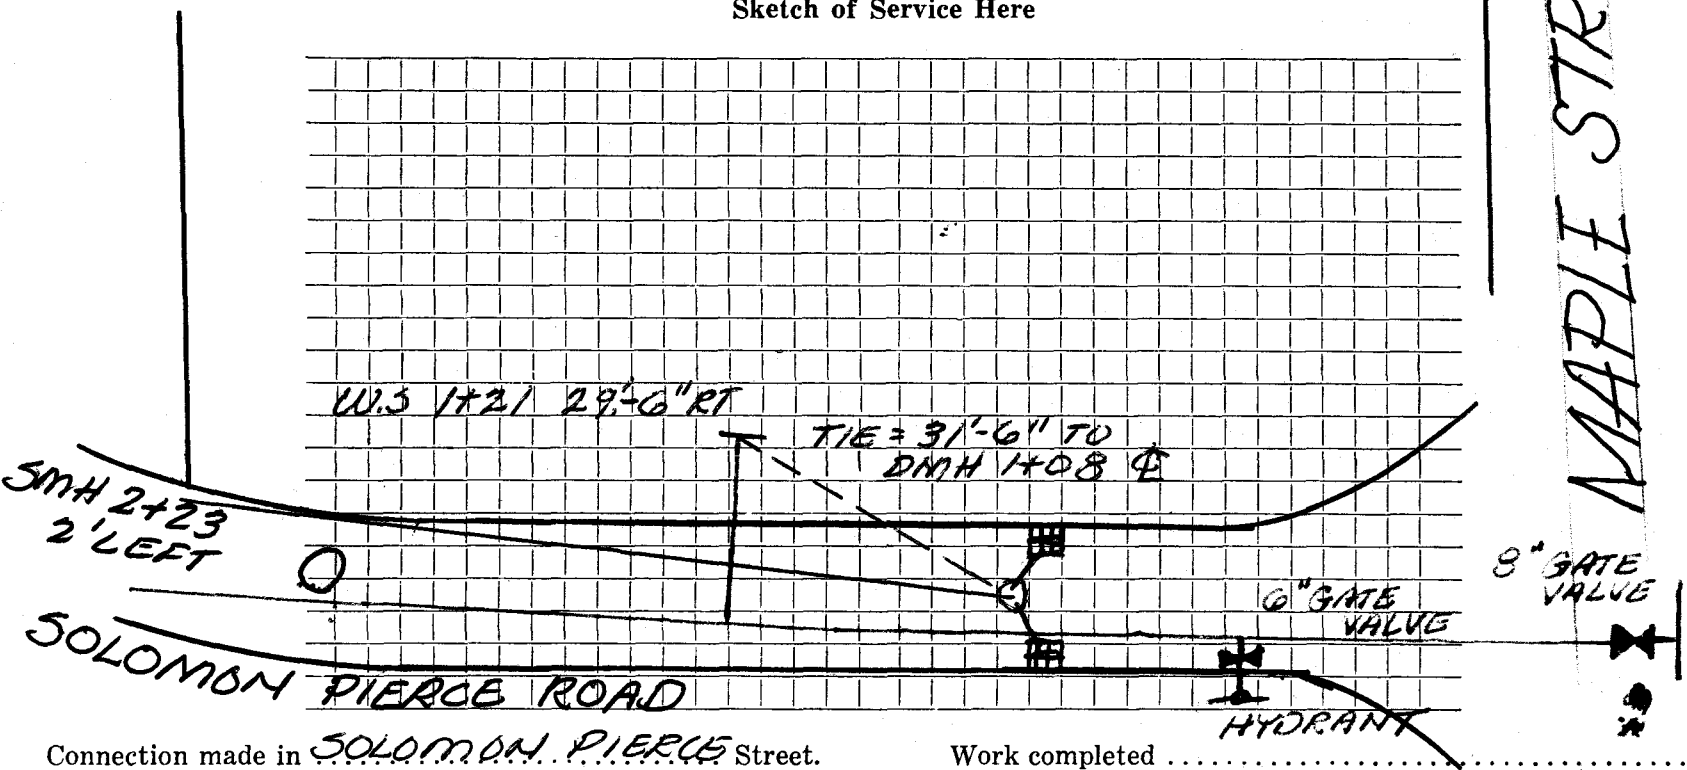

MAPLE STREET

Connection made in SOLOMON PIERCE Street.

Work completed

Remarks: 8" GATE VALVE = - 0+36 18' LT

6" GATE VALVE = 0+50 11-9" LT

HYDRANT = 0+50 20'-0" LT