


TOWN OF LEXINGTON — BOARD OF PUBLIC WORKS

LOT # WATER DIVISION
~~21~~ 21

Sketch of Service Here

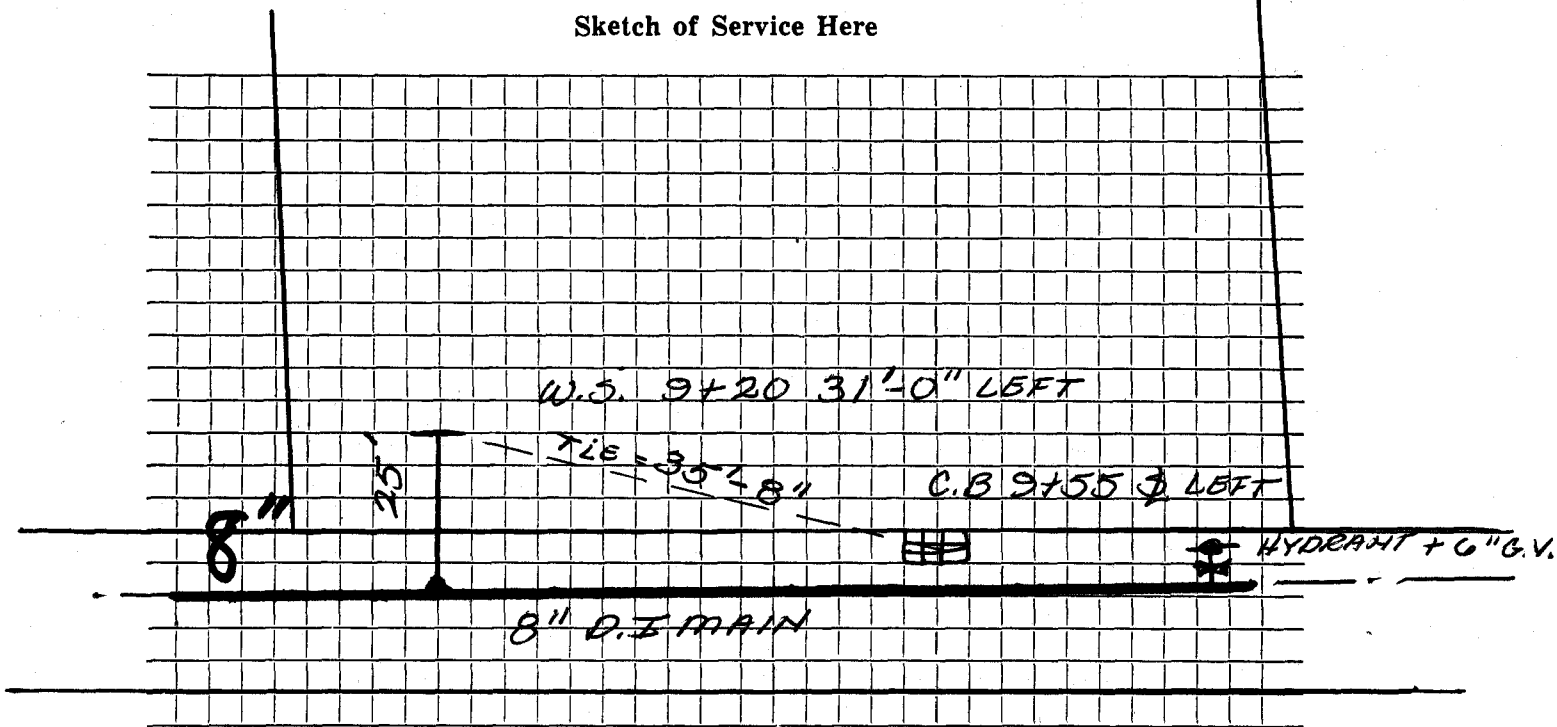

Connection made in SOLDOMON PIERCE Street. Work completed

Remarks: STA. OF HYDRANT = 10+50 20'-0" LEFT

..... STA. OF 6" GATE VALVE = 10+50 10'-3" LEFT

..... NO INSPECTION - NO INSIDE TIES