


DATE _____

TOWN OF LEXINGTON — BOARD OF PUBLIC WORKS

WATER DIVISION

LOT # 28

Sketch of Service Here

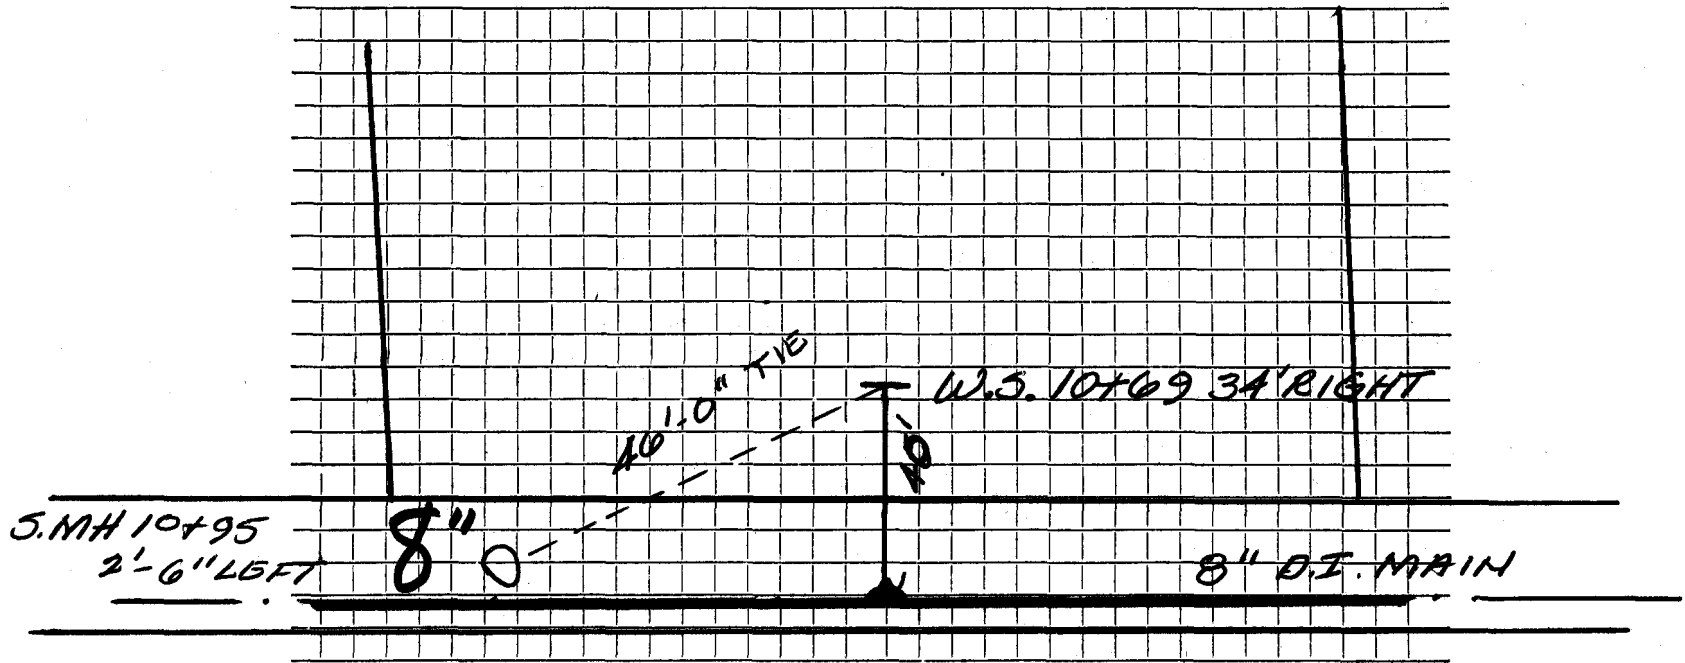

Connection made in SOLOMON PIERCE Street.

Work completed

Remarks:

.....

.....