



\*

DATE \_\_\_\_\_


# TOWN OF LEXINGTON — BOARD OF PUBLIC WORKS

## WATER DIVISION

LOT # 29 17

Sketch of Service Here

Ass. # 17

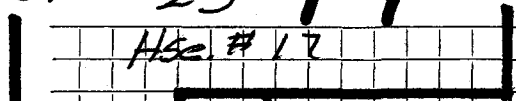

59' 0"  
33' 0"  
88' 0"

etc. U.S. 12+50 27±5" RIGHT

TIE  
100± 8"

S.M.H  
13+50

34'

8" D.I. MAIN

8"

8' RIGHT

Connection made in SOLOMON PIERCE Street.

Work completed .....

Remarks: .....

.....

.....