

*


DATE _____

TOWN OF LEXINGTON — BOARD OF PUBLIC WORKS

WATER DIVISION

LOT # 48

Sketch of Service Here

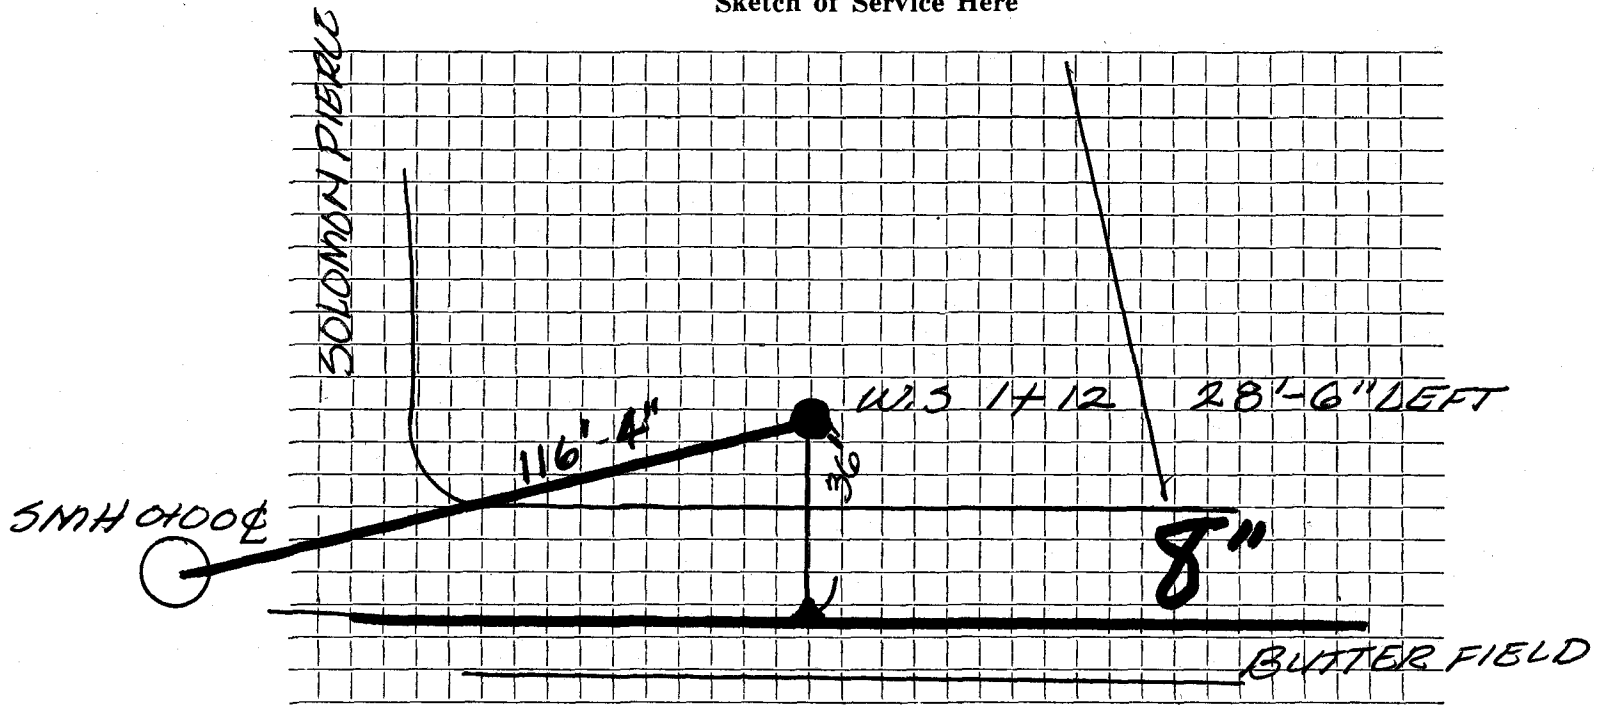

Connection made in BUTTER FIELD Street. Work completed

Remarks:
.....
.....