


DATE 10-30-'90

TOWN OF LEXINGTON — BOARD OF PUBLIC WORKS

WATER DIVISION

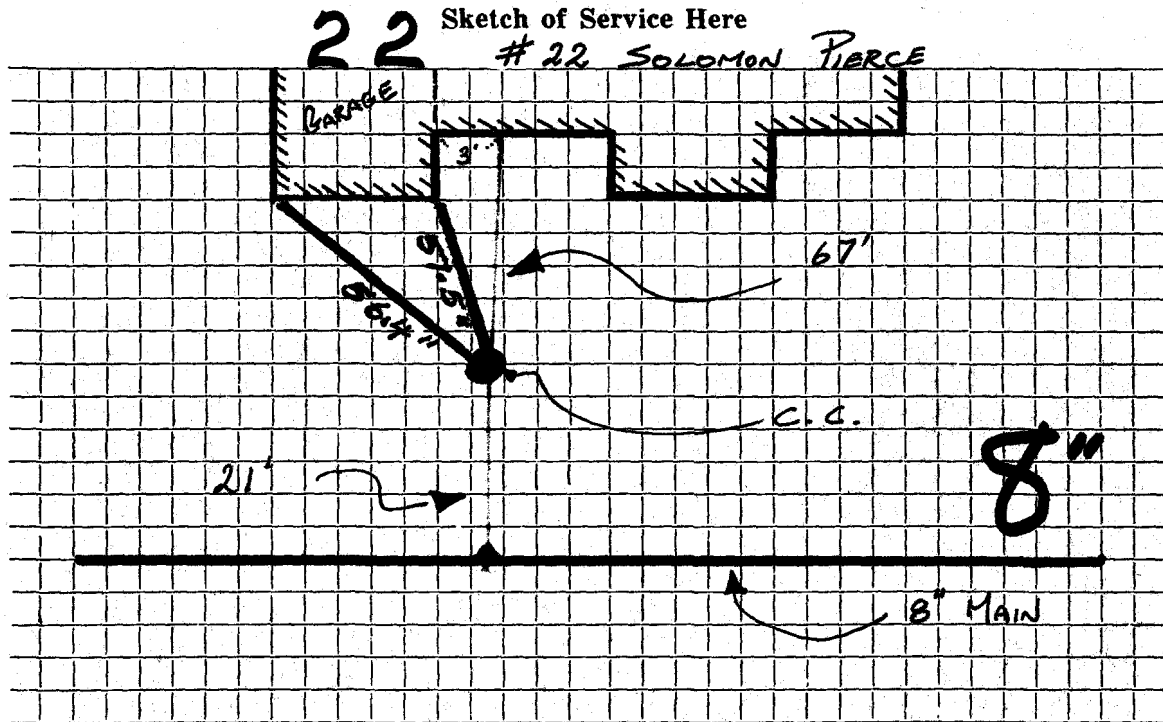

Connection made in SOLOMON PIERCE Street. Work completed

Remarks: INSPECTED 8-12-'87 BY CRG. INSTALLED BY J. Mc LAUGHLIN