

WATER SERVICE RECORD

Name

Service No.

Address # 23 Solomon Pierce Rd.

Location

Repair—Renewal—(New Service)

Date	Material	Amount	Total	Date	Amount
------	----------	--------	-------	------	--------

3/14/86

43'0" of 1" Copper


DATE \_\_\_\_\_

TOWN OF LEXINGTON — BOARD OF PUBLIC WORKS

WATER DIVISION

Sketch of Service Here

Solomon Pierce Rd.

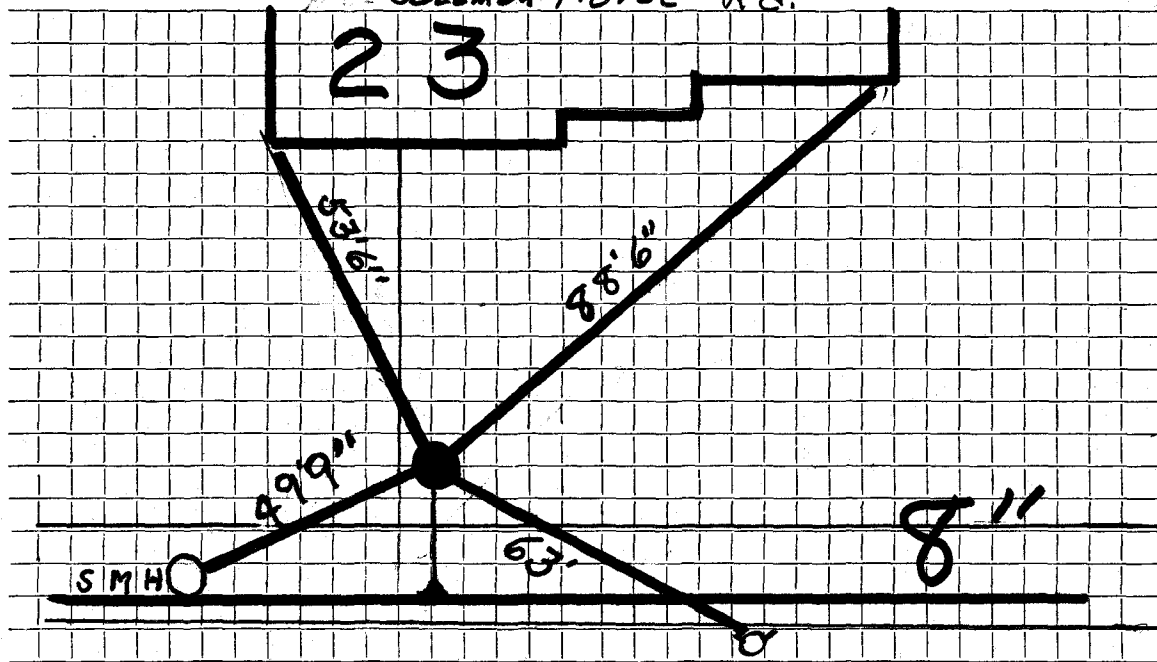

Connection made in Solomon Pierce Rd. Street

Work completed 3/14/86

Remarks: .....

.....

.....