

WATER SERVICE RECORD

Name LOT # 17 Peter D'Arrigo

Service No.

Address 24 Solomon Pierce Road Pheasant Brook Estates

Location Lexington MA

Repair—Renewal—New Service


Date	Material	Amount	Total	Date	Amount
	<u>26' (1" TYPE K COPPER)</u> <u>1" COPPER</u> <u>1" CURB / w Box</u>				
<u>1988</u>	<u>97 LF 1" COPPER</u>			<u>26' 1" Copper</u> <u>1 1" C. Corp Cock</u> <u>1 1" C. Curb Cock</u> <u>1 Box</u>	

TOWN OF LEXINGTON — BOARD OF PUBLIC WORKS

WATER DIVISION

LOT # 17

Sketch of Service Here

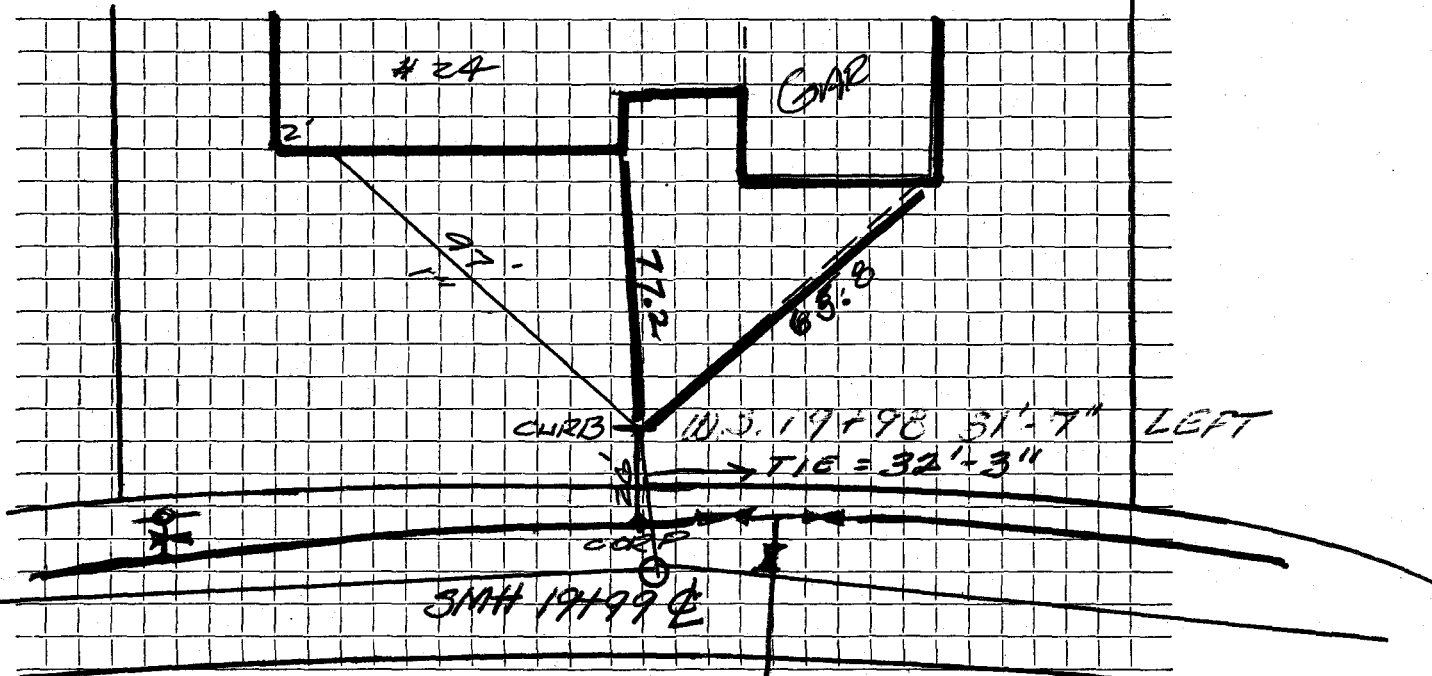

Connection made in Solomon Pierce Street.

Work completed HYDRANT = 19+17 20'-6" LEFT

Remarks: STATIONS FOR 3 8" WATER GATES

20+13.0	6'-7" LEFT	20+19.3	1' LEFT
	20+26	7' LEFT	6" G.V. = 19+17 10'-7" LEFT