




DATE \_\_\_\_\_

TOWN OF LEXINGTON — BOARD OF PUBLIC WORKS  
WATER DIVISION

Sketch of Service Here

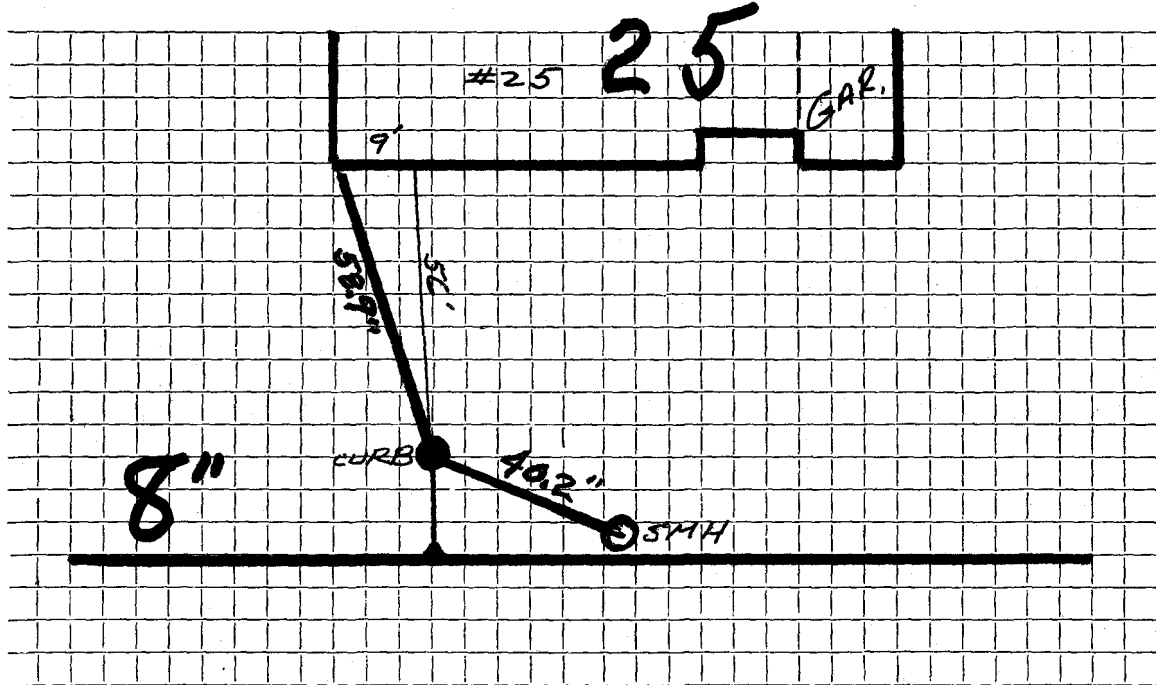

Connection made in Solomon Pierce Street. Work completed .....

Remarks: Subd. 10.15.10.11 .....