


DATE _____

TOWN OF LEXINGTON — BOARD OF PUBLIC WORKS

WATER DIVISION

LOT # 16

Sketch of Service Here

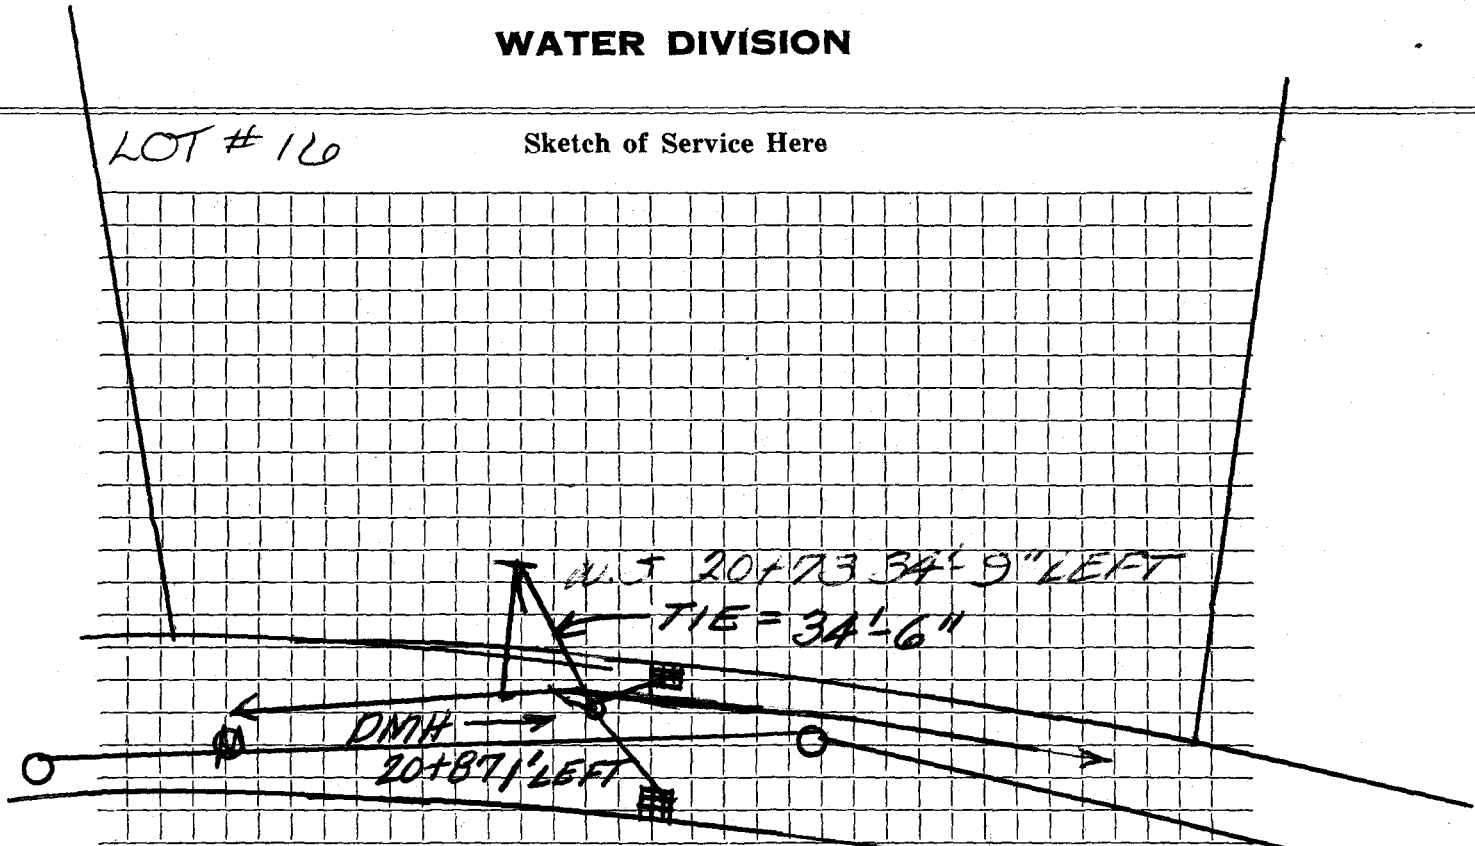

Connection made in Solomon Pierce Street. Work completed

Remarks:
.....
.....