

WATER SERVICE RECORD

Name LOT # 44

Service No.

Address 7 SOLOMON PIERCE ROAD PHEASANT BROOK ESTATES.

Location LEXINGTON MA.

Repair—Renewal—New Service

Date	Material	Amount	Total	Date	Amount
	41' OF 1" TYPE K COPPER.				
1986	① Union 98'0" of 1" copper			41' 1" Copper	

*

DATE _____


TOWN OF LEXINGTON — BOARD OF PUBLIC WORKS

WATER DIVISION

27

LOT # 44

Sketch of Service Here

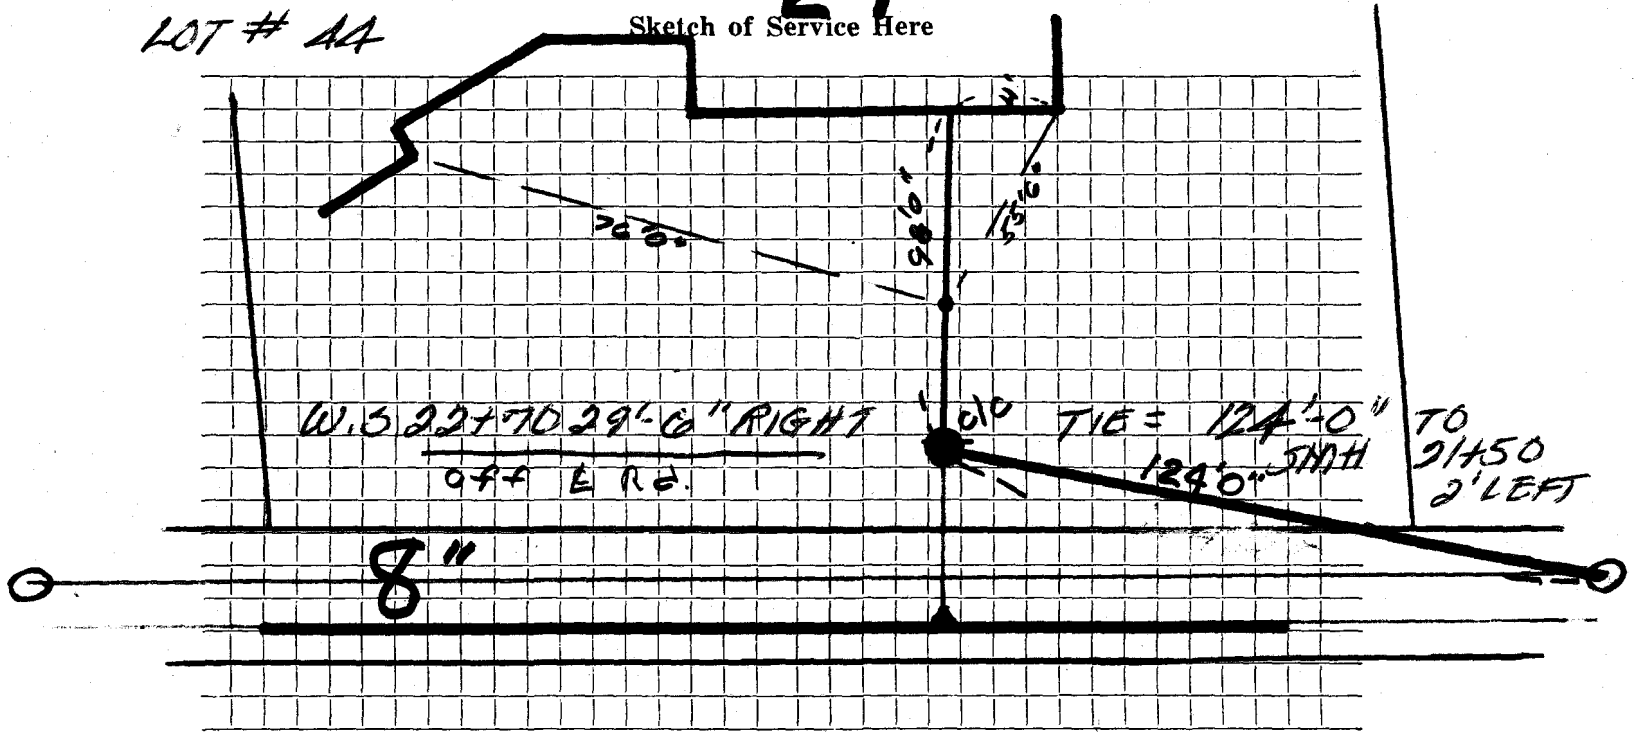

Connection made in SOLOMON PIERCE Street.

Work completed

Remarks:

.....

.....